

CERTIFICATE OF LOCATION OF GOVERNMENT CORNER

County of Anoka

State of Minnesota


East 1/4 Corner of Sec. 10 Township 32 Range 23

On the 13th day of February, 1961, the described corner was evidenced by an iron pipe

and to perpetuate the location of said corner, at the exact location thereof, a permanent marker was placed consisting of a cast iron monument

AND on the 18th day of February, 2021, said permanent marker was found down 0.1'± and the ties were updated

Updated reference ties are as shown below.

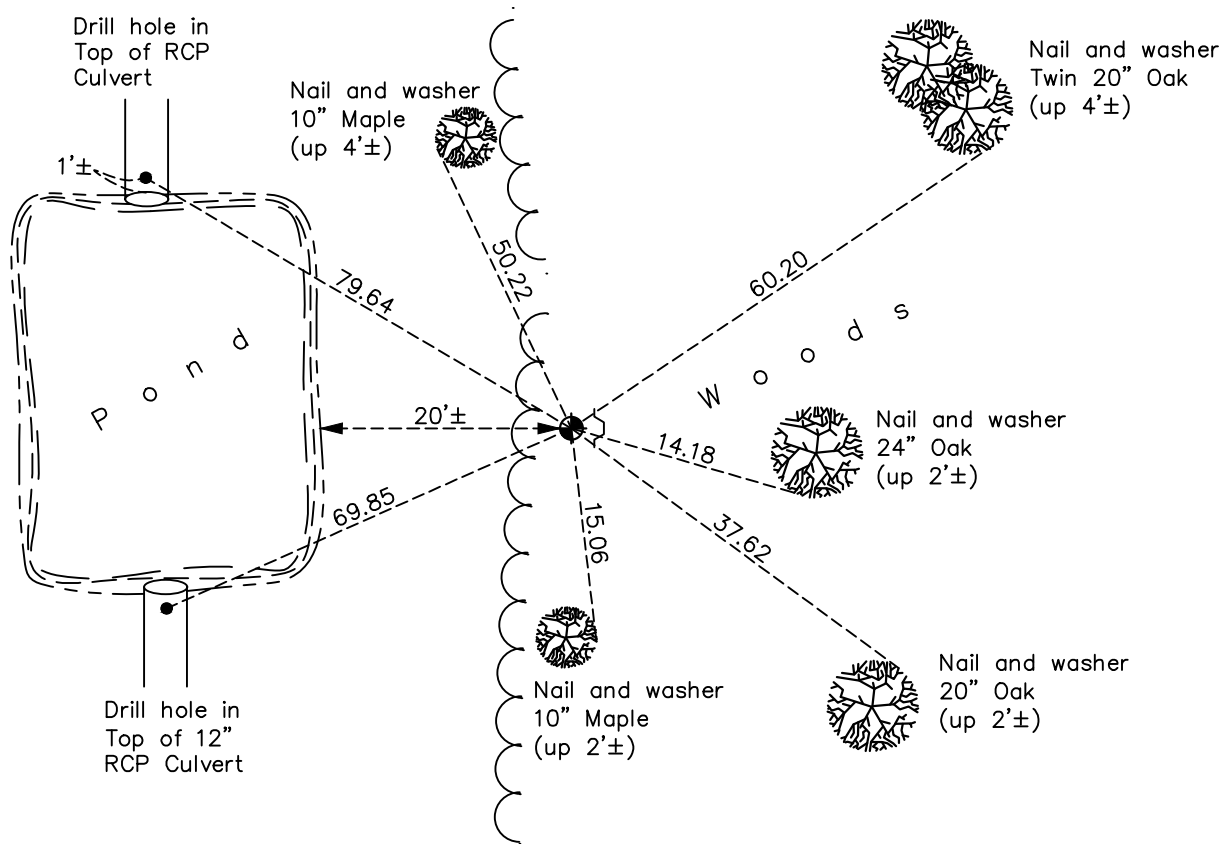

Revision Date
7/09/2021

N.A.D. 1983 Coordinates
(1996 Adjustment)

County Project Coordinates	
Northing	<u>187910.8453</u>
Easting	<u>521443.3231</u>
Date	<u>9/05/01</u>

I hereby certify that this United States public land survey monument record is correct and complete to the best of my knowledge and belief.

David Zieglmeier Date 5/31/22

David M. Zieglmeier Anoka County Deputy Surveyor
Minnesota License Number 46179

HISTORY OF GOVERNMENT CORNER

Page No. 41

County of Anoka

State of Minnesota

East 1/4 Corner of Sec. 10 Township 32 Range 23

CORNER HISTORY:

February 1855 - This corner was established by Hiram Taylor, Deputy Surveyor. Taylor marked the position by "Set quarter section post" with two bearing trees marked as accessories.

February 13, 1961 - Found 1/2" iron pipe up 1' between fence posts (fence lines run east west and north).
Updated ties.

July 17, 1964 - Found iron pipe and updated ties.

June 17, 1971 - Found iron pipe and replaced with a cast iron monument flush using corner ties. Updated ties.

June 9, 1975 - Found cast iron monument and updated ties.

June 9, 1978 - Found cast iron monument and updated ties.

November 7, 1990 - Found cast iron monument and updated ties.

August 27, 1996 - Found cast iron monument and updated ties.

September 5, 2001 - Established NAD 1983 (1996 adj.) Anoka County project coordinates by static GPS methods.

March 23, 2011 - Found cast iron monument and updated ties. Set sign and post on east side 5/4/11.

February 15, 2017 - Found cast iron monument down 0.1'± and updated ties.

February 18, 2021 - Found cast iron monument down 0.1'± and updated ties. Verified position by VRS GPS methods.