

CERTIFICATE OF LOCATION OF GOVERNMENT CORNER

County of Anoka

State of Minnesota


Witness Corner of Sec. 15 Township 32 Range 23
(on north line of NW1/4)

On the 25th day of May, 1977, the described corner was evidenced by area resurvey

and to perpetuate the location of said corner, at the exact location thereof, a permanent marker was placed consisting of a cast iron monument with a sign and post on the south side

AND on the 12th day of April, 2021, said permanent marker was found flush and the ties were updated

Updated reference ties are as shown below.

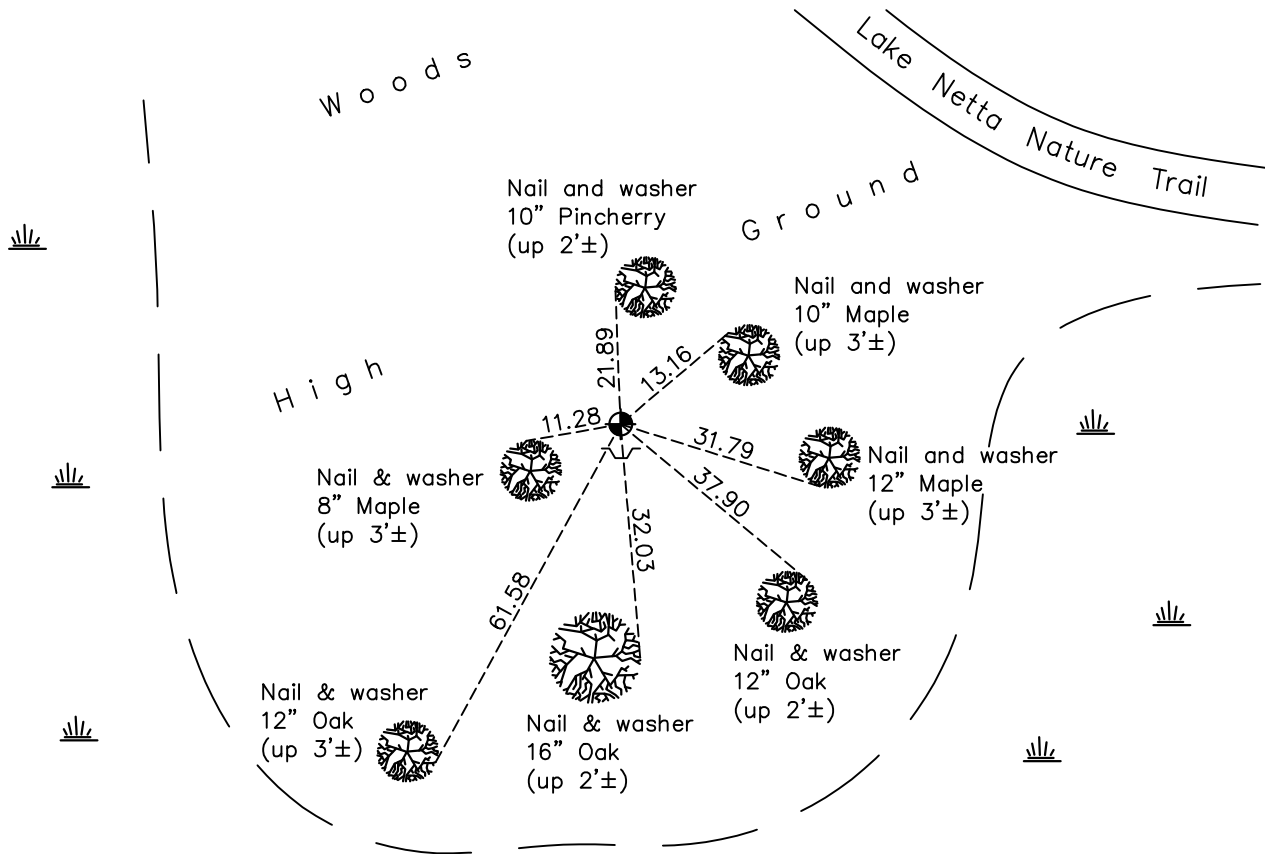

Revision Date
7/19/2021

N.A.D. 1983 Coordinates
(1996 Adjustment)

County Project Coordinates	
Northing	<u>185409.1360</u>
Easting	<u>516921.6196</u>
Date	<u>1/16/02</u>

I hereby certify that this United States public land survey monument record is correct and complete to the best of my knowledge and belief.
David Zieglmeier Date 5/31/22
 David Zieglmeier Anoka County Surveyor
 Minnesota License Number 46179

HISTORY OF GOVERNMENT CORNER

Page No. 51

County of Anoka

State of Minnesota

Witness Corner of Sec. 15 Township 32 Range 23
(on north line of NW1/4)

CORNER HISTORY:

May 25, 1977 - Set cast iron monument flush using area resurvey. Established ties to monument. Set sign and post on north side of monument.

June 12, 1978 - Found cast iron monument and updated ties.

April 2, 1986 - Found cast iron monument and updated ties after storm damage to area. Reset sign and post on the south side.

November 19, 1991 - Found cast iron monument and updated ties.

August 26, 1996 - Found cast iron monument and updated ties.

January 16, 2002 - Established NAD 1983 (1996 adj.) Anoka County project coordinates by static GPS methods.

April 5, 2011 - Found cast iron monument and updated ties.

March 14, 2017 - Found cast iron monument flush and updated ties.

April 12, 2021 - Found cast iron monument flush and updated ties.