

CERTIFICATE OF LOCATION OF GOVERNMENT CORNER

County of Anoka

State of Minnesota



West 1/4 Corner of Sec. 16 Township 32 Range 23

On the 14th day of May, 1960, the described corner was evidenced by a concrete monument

and to perpetuate the location of said corner, at the exact location thereof, a permanent marker was placed consisting of a cast iron monument

AND on the 17th day of February, 2021, said permanent marker was found down 0.2'± and the ties were updated

Updated reference ties are as shown below.

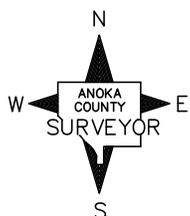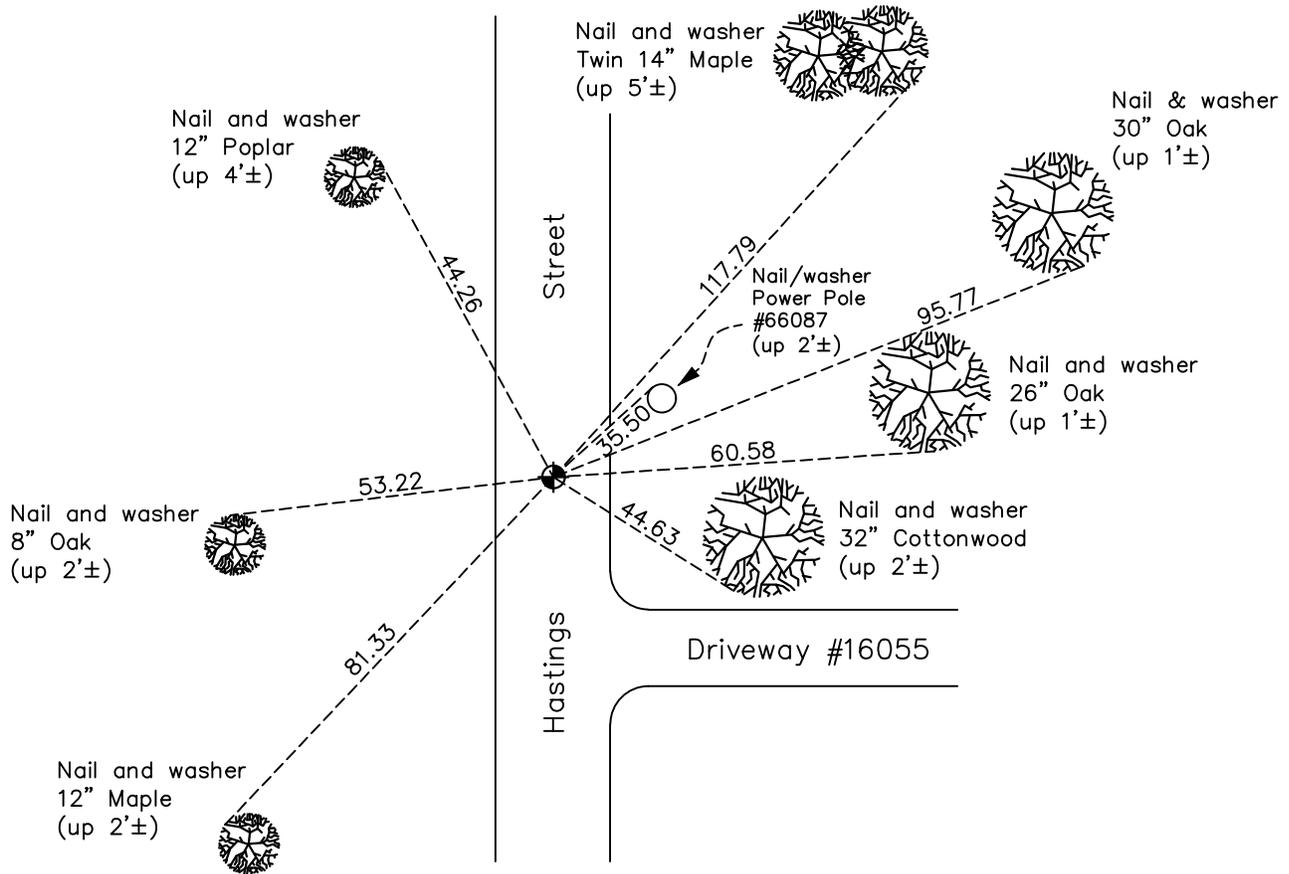

Revision Date
7/20/2021

N.A.D. 1983 Coordinates
(1996 Adjustment)

County Project Coordinates	
Northing	<u>182933.2784</u>
Easting	<u>510842.5283</u>
Date	<u>11/20/01</u>

I hereby certify that this United States public land survey monument record is correct and complete to the best of my knowledge and belief.

David Zieglmeier Date 7/12/22

David Zieglmeier Anoka County Surveyor
Minnesota License Number 46179

HISTORY OF GOVERNMENT CORNER

Page No. 60

County of Anoka

State of Minnesota

West 1/4 Corner of Sec. 16 Township 32 Range 23

CORNER HISTORY:

February 1855 - This corner was established by Hiram Taylor, Deputy Surveyor. Taylor marked the position by "Set quarter section post" with one bearing tree marked as an accessory.

November 29, 1948 - N.C. Hoium found a concrete monument with an iron pipe on the north side. Updated ties.

May 14, 1960 - Found a concrete monument with a cast iron monument placed on top down 0.2'±. Updated ties.

July 15, 1964 - Found a concrete monument with a cast iron monument placed on top down 0.2'±. Updated ties.

June 7, 1971 - Found cast iron monument down 0.7'± in road. Updated ties.

June 10, 1975 - Found cast iron monument and updated ties.

June 12, 1978 - Found cast iron monument and updated ties.

June 27, 1984 - Found cast iron monument and updated ties.

July 6, 1981 - Found cast iron monument and updated ties.

June 26, 1987 - Found cast iron monument and updated ties.

October 26, 1988 - Found cast iron monument and updated ties.

June 16, 1992 - Found cast iron monument and updated ties.

August 16, 1996 - Found cast iron monument and updated ties.

November 20, 2001 - Established NAD 1983 (1996 adj.) Anoka County project coordinates by static GPS methods.

February 25, 2011 - Found cast iron monument down 0.3'± and updated ties.

March 16, 2017 - Found cast iron monument down 0.2'±. Verified position by VRS GPS methods. Updated ties.

February 17, 2021 - Found cast iron monument down 0.2'±. Updated ties. Verified position by VRS GPS method.