

CERTIFICATE OF LOCATION OF GOVERNMENT CORNER

County of Anoka

State of Minnesota



West 1/4 Corner of Sec. 14 Township 32 Range 23

On the 2nd day of November, 1966, the described corner was evidenced by area resurvey

and to perpetuate the location of said corner, at the exact location thereof, a permanent marker was placed consisting of a red and white 2" square steel Telespar monument with a sign attached to the south side

AND on the 12th day of April, 2021, said permanent marker was found w/2" sq. steel Telespar mont. up 2.5'± w/punchmarked "Co. Surveyor" cap. Updated ties.

Updated reference ties are as shown below.

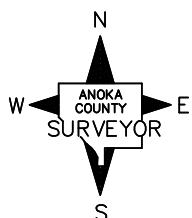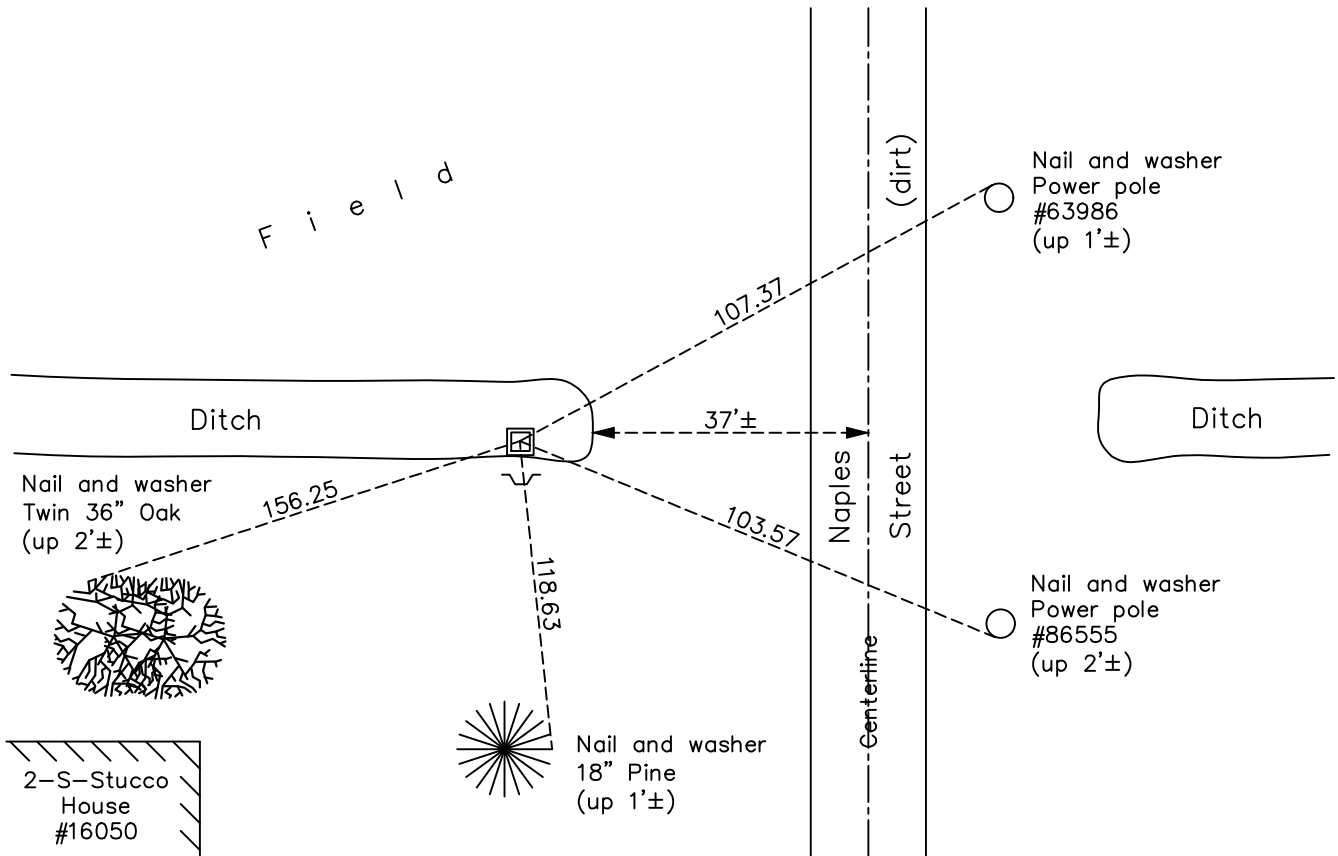

Revision Date
7/20/2021

N.A.D. 1983 Coordinates
(1996 Adjustment)

County Project Coordinates	
Northing	<u>182649.2151</u>
Easting	<u>521454.8560</u>
Date	<u>9/04/01</u>

I hereby certify that this United States public land survey monument record is correct and complete to the best of my knowledge and belief.

David Zieglmeier Date 7/14/22

David Zieglmeier Anoka County Surveyor
Minnesota License Number 46179

HISTORY OF GOVERNMENT CORNER

Page No. 62

County of Anoka

State of Minnesota

West 1/4 Corner of Sec. 14 Township 32 Range 23

CORNER HISTORY:

February 1855 - This corner was established by Hiram Taylor, Deputy Surveyor. Taylor marked the position by "Set quarter section post" with one bearing tree marked as an accessory.

November 2, 1966 - Set 1-1/4" red and white iron pipe up 3'± using area resurvey. Established tie to pipe.

May 17, 1971 - Found 1-1/4" red and white iron pipe and updated ties.

July 17, 1975 - Found 1-1/4" red and white iron pipe and updated ties.

June 13, 1978 - Found 1-1/4" red and white iron pipe and updated ties.

June 29, 1984 - Found 1-1/4" red and white iron pipe and updated ties.

May 20, 1992 - Found old 1-1/4" red and white iron pipe and replaced with a new red and white iron pipe. Updated ties.

August 21, 1996 - Found red and white iron pipe and updated ties.

September 4, 2001 - Established NAD 1983 (1996 adj.) Anoka County project coordinates by static GPS methods.

March 24, 2011 - Found 2" square red and white steel Telspar monument with sign attached (set date unknown). Updated ties to Telspar monument.

February 16, 2017 - Found 2" square red and white steel Telspar monument in need of reset.

August 17, 2017 - Found 2" square red and white steel Telspar monument with top broken off, Bottom of monument found 0.3'± below water level in ditch and leaning.

September 18, 2017 - Replaced broken Telspar base with a new 2" x 2" x 8' steel Telspar monument with punchmarked cap up 2.5'±. Verified position by VRS GPS methods. Updated ties. Set sign and post on south side.

April 12, 2021 - Found 2" square steel Telspar monument with punchmarked cap up 2.5' ± w/ sign and post on the South Side. Updated Ties. Verified position of corner by VRS GPS method.