

CERTIFICATE OF LOCATION OF GOVERNMENT CORNER

County of Anoka



State of Minnesota

East 1/4 Corner of Sec. 13 Township 32 Range 23

On the 4th day of March, 1976, the described corner was evidenced by area resurvey

and to perpetuate the location of said corner, at the exact location thereof, a permanent marker was placed consisting of a 2" square steel Telespar monument up 1.0'± with a 'County Surveyor' cap & 'T' punchmark and with a sign and post on the north side

AND on the 29th day of December, 2022, said permanent marker was reset to be a 2" square Telspar with cap & 'T' punchmark, set up 1'±, by RTK GPS Method. Set sign & post 4'± to North.
Update the ties.
Updated reference ties are as shown below.

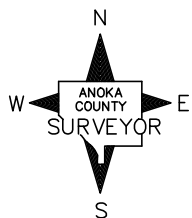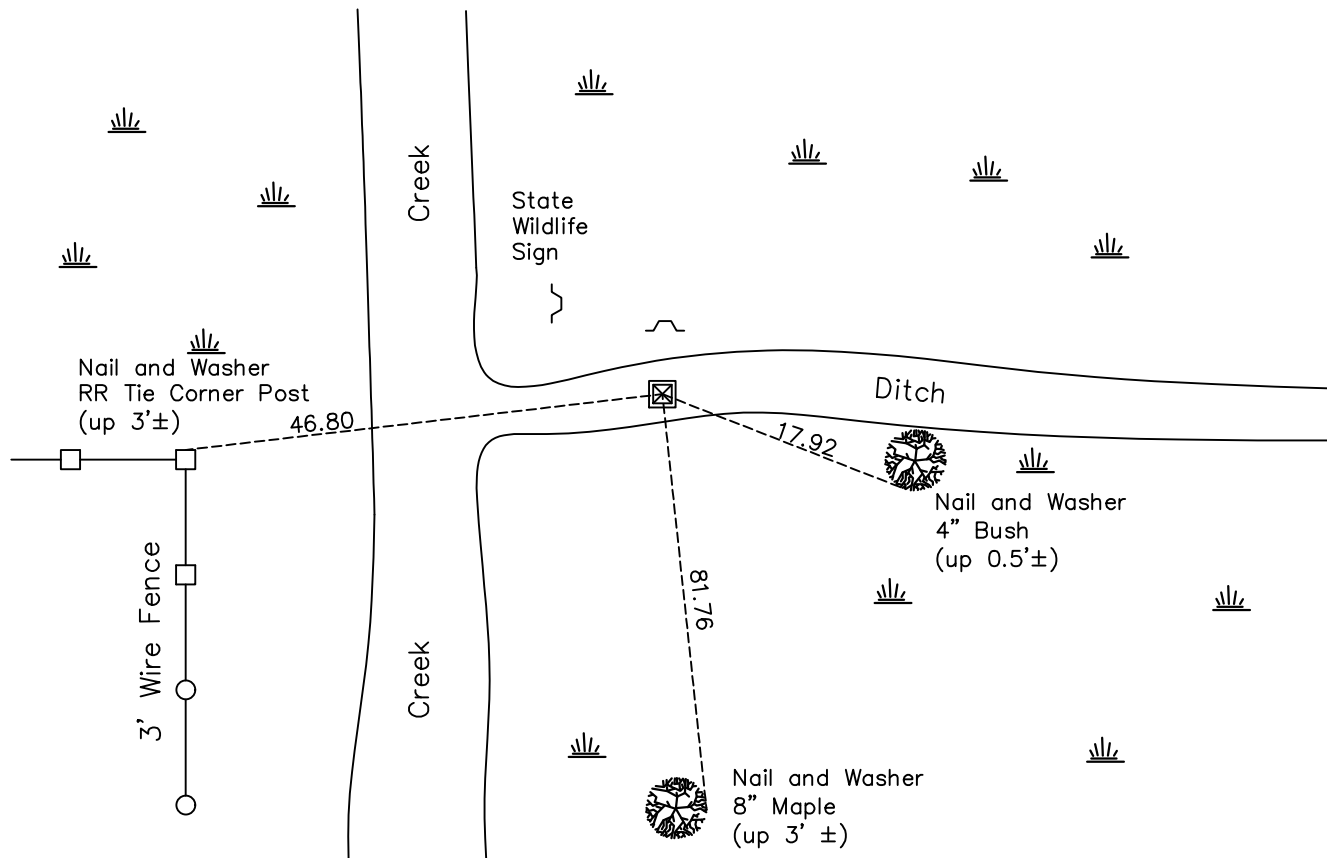

Revision Date

1/03/2023

N.A.D. 1983 Coordinates
(1996 Adjustment)

County Project Coordinates	
Northing	<u>182525.0648</u>
Easting	<u>532035.8847</u>
Date	<u>2/13/02</u>

I hereby certify that this United States public land survey monument record is correct and complete to the best of my knowledge and belief.

David Zieglmeier Date 1/3/24

David Zieglmeier Anoka County Surveyor
Minnesota License Number 46179

HISTORY OF GOVERNMENT CORNER

Page No. 64

County of Anoka

State of Minnesota

East 1/4 Corner of Sec. 13 Township 32 Range 23

CORNER HISTORY:

Date:

Jan 1915 - E.G Maxwell set 4" x 4" x 36" concrete monument while resurveying township plat.

October 28, 1965 - Set Red & White Iron Pipe from Area Resurvey. Created ties.

June 21, 1971 - Found Red & White IP up 4' ± and updated ties.

March 4, 1976 - Found Red & White IP up 4' ± and updated ties.

July 16, 1984 - Found Red & White IP up 4' ± and updated ties.

February 13, 2002 - Found Red & White IP up 4' ± and updated ties.

February 16, 2017 - Found 1" red & white IP 6'± above surface bent over, laying down

December 29, 2022 - Iron Pipe found 4'± East of position laying in ditch. Reset with a 2" square Telspar with cap and 'T' punch mark, set up 1'±, by RTK GPS method. Set new sign and post 4'± North. Updated the ties.