

CERTIFICATE OF LOCATION OF GOVERNMENT CORNER

County of Anoka

State of Minnesota


South 1/4 Corner of Sec. 15 Township 32 Range 23

On the 9th day of November, 1967, the described corner was evidenced by area resurvey

and to perpetuate the location of said corner, at the exact location thereof, a permanent marker was placed consisting of an iron pipe

AND on the 22nd day of February, 2021, said permanent marker was found 2" square steel Telespar monument up 2'± w/"County Surveyor" cap. The ties were updated.

Updated reference ties are as shown below.

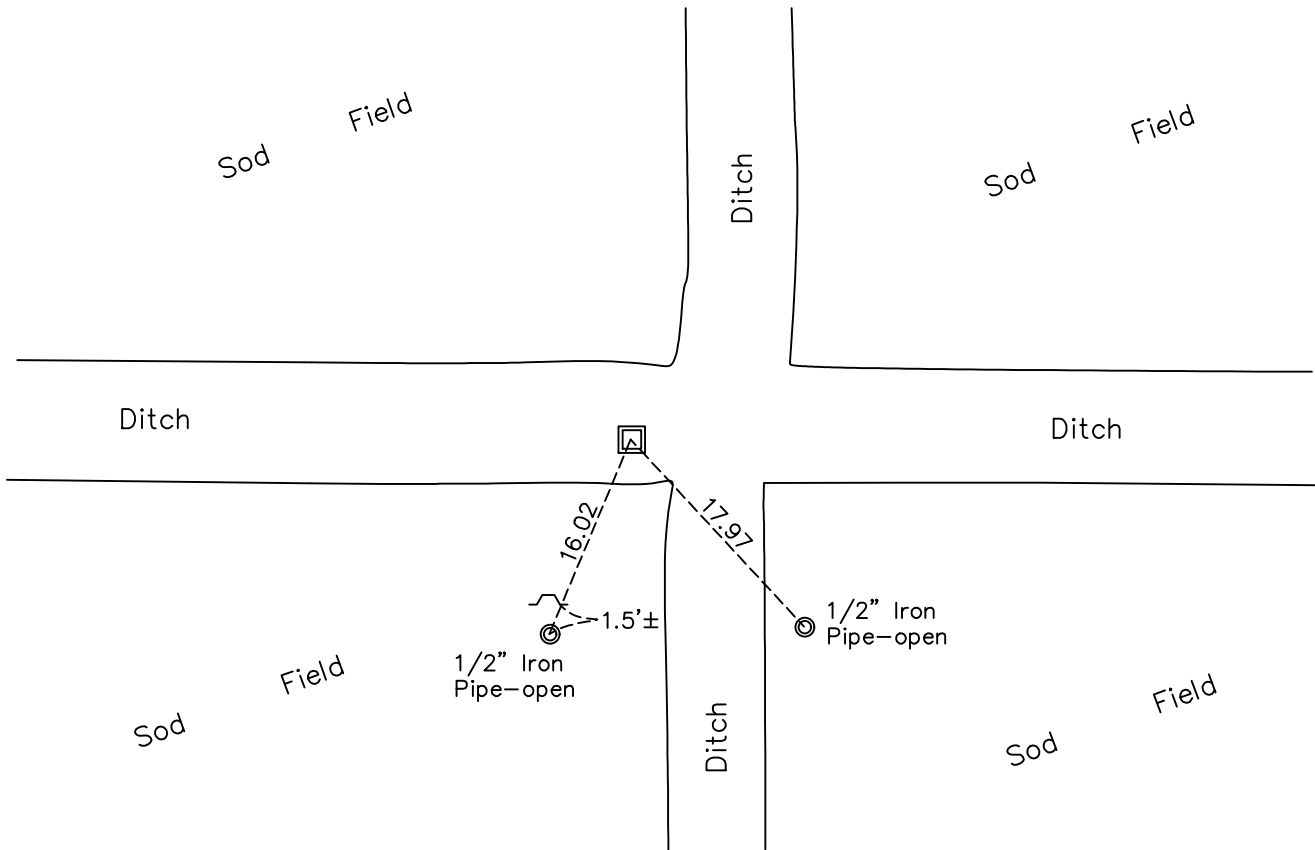

N

 S

Revision Date
7/21/2021

N.A.D. 1983 Coordinates
(1996 Adjustment)

County Project Coordinates	
Northing	<u>180078.1541</u>
Easting	<u>518766.9514</u>
Date	<u>9/10/01</u>

I hereby certify that this United States public land survey monument record is correct and complete to the best of my knowledge and belief.

David Zieglmeier Date 7/14/22

David Zieglmeier Anoka County Surveyor
 Minnesota License Number 46179

HISTORY OF GOVERNMENT CORNER

Page No. 70

County of Anoka

State of Minnesota

South 1/4 Corner of Sec. 15 Township 32 Range 23

CORNER HISTORY:

February 1855 - This corner was established by Hiram Taylor, Deputy Surveyor. Taylor marked the position by "Set quarter section post" with two bearing trees marked as accessories.

September 7, 1966 - Set red and white iron pipe up 3'± in center line of dry ditch. Established ties to iron pipe.

November 9, 1967 - Reset red and white iron pipe up 3'± using area resurvey. Updated ties.

May 18, 1977 - Found red and white iron pipe removed due to ditch construction. Reset new red and white iron pipe using area resurvey. Set 1/2" iron pipes with signs to the southwest and southeast as witness irons. Updated ties.

June 14, 1978 - Found red and white iron pipe and updated ties.

July 12, 1984 - Found red and white iron pipe and updated ties.

January 2, 1991 - Found red and white iron pipe and updated ties.

October 8, 2001 - Found red and white iron pipe and updated ties. Established NAD 1983 (1996 adj.) Anoka County project coordinates by static GPS methods.

April 22, 2011 - Found red and white iron pipe (paint worn off and appears to be leaning northerly 0.2'±). Updated ties.

March 23, 2017 - Found iron pipe missing. In need of reset.

August 31, 2017 - Set temporary capped 1/2" iron pipe using VRS GPS methods.

September 7, 2017 - Set 2" square steel Telspar monument w/'County surveyor' cap up 2'± using static GPS methods. Verified position by VRS GPS methods. Updated ties.

February 22, 2021 - Found 2" square steel Telspar monument w/'County surveyor' cap up 2'± and updated ties. Verified position by VRS GPS method.