

CERTIFICATE OF LOCATION OF GOVERNMENT CORNER

County of Anoka

State of Minnesota


Meander Corner of Sec. 20 Township 32 Range 23 (on north line of NE1/4)

On the 25th day of September, 1961, the described corner was evidenced by a sandstone monument

and to perpetuate the location of said corner, at the exact location thereof, a permanent marker was placed consisting of an iron pipe with a bronze cap marked "US General Land Office Survey-1919"

AND on the 18th day of February, 2021, said permanent marker was found down 0.3'± and the ties were updated

Updated reference ties are as shown below.

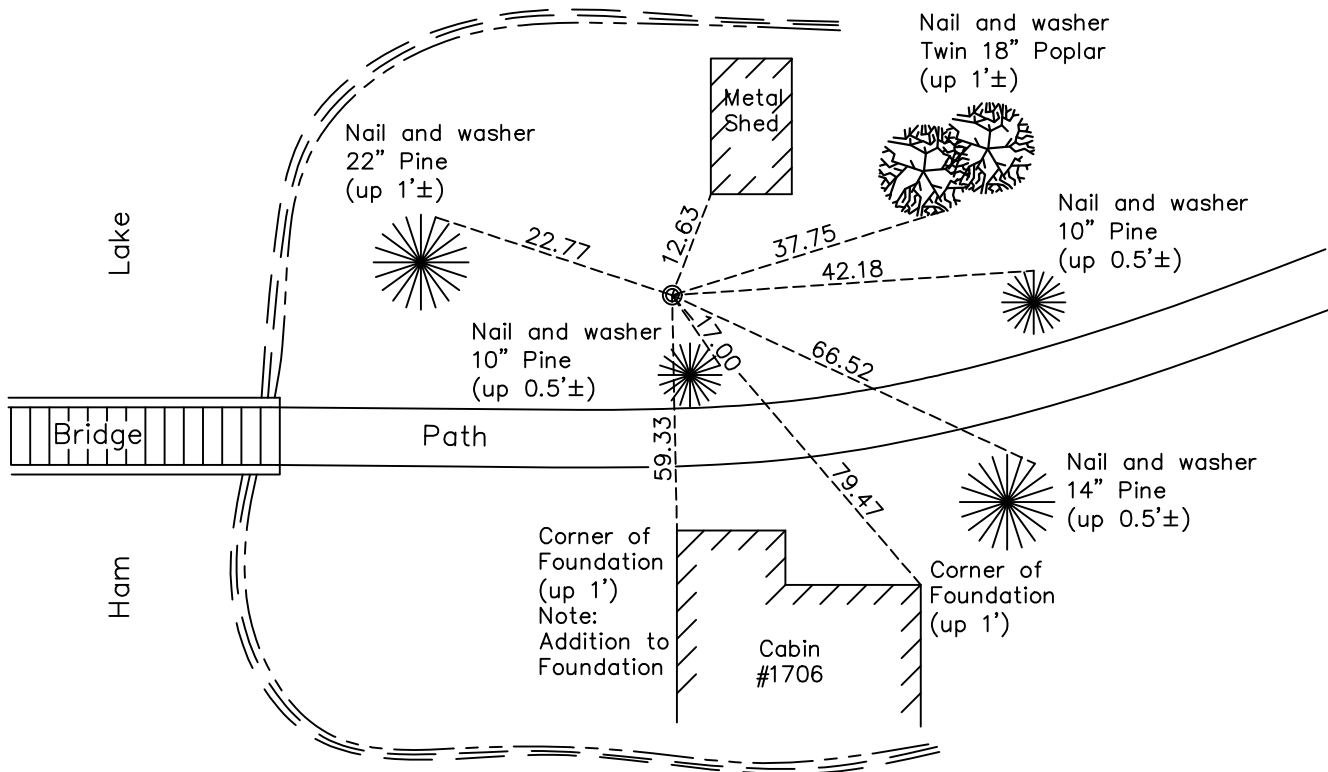

Revision Date
7/22/2021

N.A.D. 1983 Coordinates
(1996 Adjustment)

County Project Coordinates	
Northing	<u>180249.1391</u>
Easting	<u>510256.7827</u>
Date	<u>2/05/02</u>

I hereby certify that this United States public land survey monument record is correct and complete to the best of my knowledge and belief.

David Zieglmeier Date 7/21/22

David Zieglmeier Anoka County Surveyor
Minnesota License Number 46179

HISTORY OF GOVERNMENT CORNER

Page No. 77

County of Anoka

State of Minnesota

Meander Corner of Sec. 20 Township 32 Range 23 (on north line of NE1/4)

CORNER HISTORY:

1961 - Found iron pipe with bronze cap marked "U.S. General Land Office" down 0.1'±. Updated ties.

July 13, 1964 - Found iron pipe with bronze cap and updated ties.

August 11, 1966 - Found iron pipe with bronze cap and updated ties.

June 18, 1975 - Found iron pipe with bronze cap and updated ties.

June 15, 1978 - Found iron pipe with bronze cap and updated ties.

June 26, 1987 - Found iron pipe with bronze cap and updated ties.

June 17, 1992 - Found iron pipe with bronze cap and updated ties.

June 29, 1994 - Found iron pipe with bronze cap and updated ties.

August 5, 1996 - Found iron pipe with bronze cap and updated ties.

February 5, 2002 - Found iron pipe with bronze cap and updated ties. Established NAD 1983 (1996 adj.) Anoka County project coordinates by static GPS methods.

April 29, 2011 - Found iron pipe with bronze cap and updated ties.

February 16, 2017 - Found iron pipe with bronze cap down 0.3'± and updated ties.

February 18, 2021 - Found iron pipe with bronze cap down 0.3'± and updated ties. Verified position by VRS GPS method.