

CERTIFICATE OF LOCATION OF GOVERNMENT CORNER

County of Anoka


State of Minnesota

Center Corner of Sec. 20 Township 32 Range 23

I hereby certify that on the 3 day of March, 1973, I found the described corner which was evidenced by 1" iron pipe

and I further certify that to perpetuate the location of said corner, I did, at the exact location thereof, place a permanent marker consisting of SAME

which reference or witness monuments are located in the manner following:

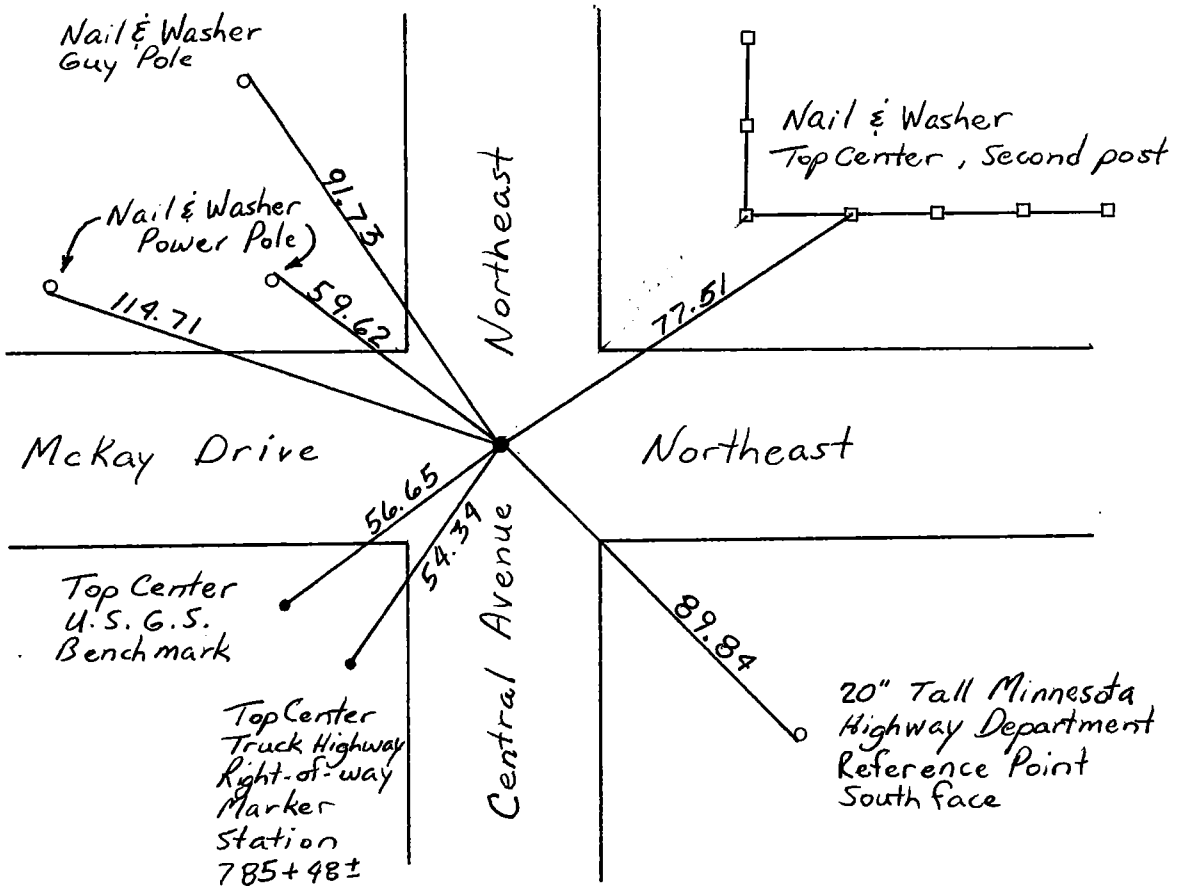

Revised date
6-15-78
7-10-84

By
D. Dahl
R. Bennett

Minnesota State Plane Coordinates
 South Zone
 Y _____ X _____
 _____, _____
 County Surveyor Date
 Registered Land Surveyor No. _____