

CERTIFICATE OF LOCATION OF GOVERNMENT CORNER

County of Anoka

State of Minnesota


West 1/4 Corner of Sec. 23 Township 32 Range 23

On the 2nd day of September, 1966, the described corner was evidenced by area resurvey

and to perpetuate the location of said corner, at the exact location thereof, a permanent marker was placed consisting of a cast iron monument

AND on the 13th day of April, 2021, said permanent marker was found down 0.4'± and the ties were updated

Updated reference ties are as shown below.

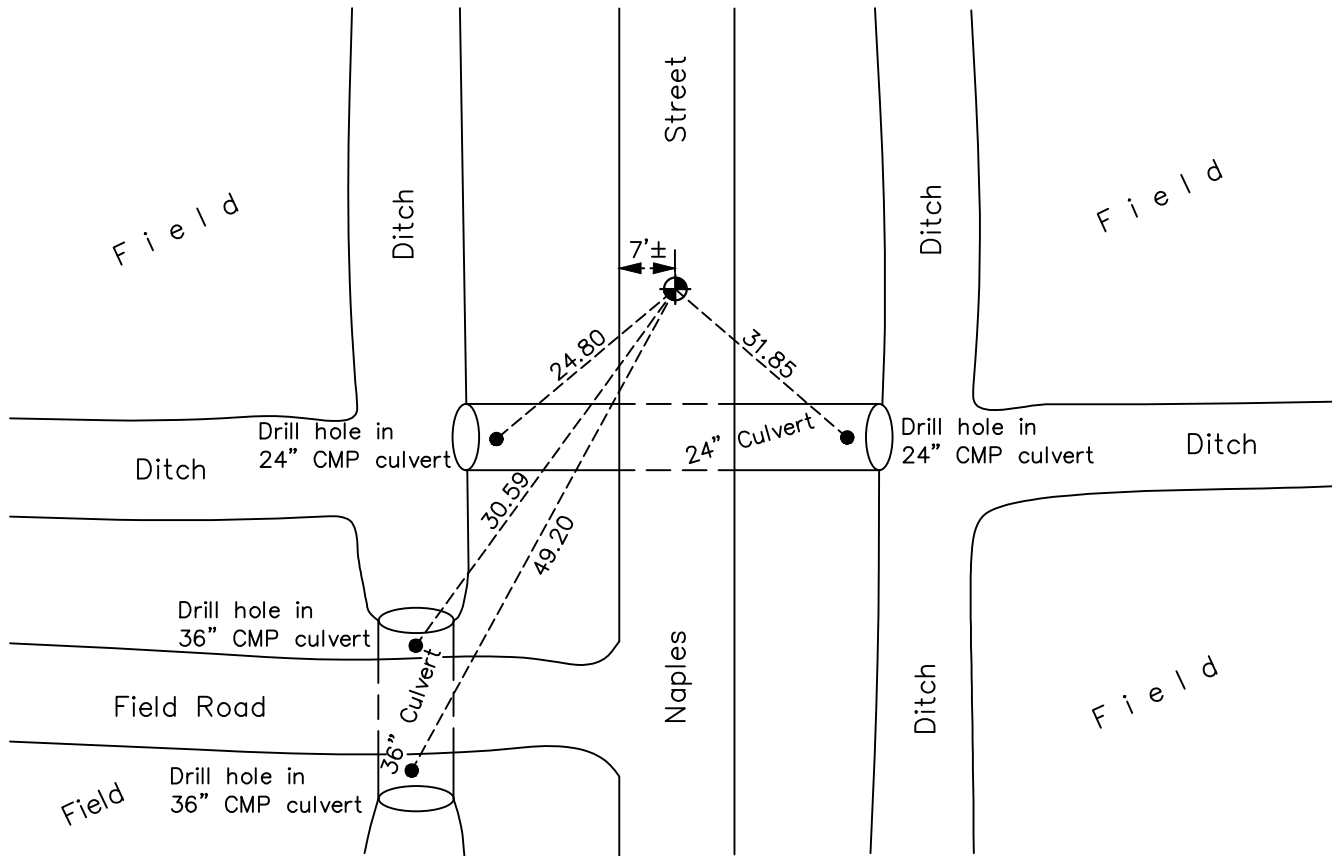

Revision Date
7/23/2021

N.A.D. 1983 Coordinates
(1996 Adjustment)

County Project Coordinates	
Northing	<u>177385.7683</u>
Easting	<u>521432.1025</u>
Date	<u>9/18/01</u>

I hereby certify that this United States public land survey monument record is correct and complete to the best of my knowledge and belief.

David Zieglmeier Date 7/21/22

David Zieglmeier Anoka County Surveyor
Minnesota License Number 46179

HISTORY OF GOVERNMENT CORNER

Page No. 86

County of Anoka

State of Minnesota

West 1/4 Corner of Sec. 23 Township 32 Range 23

CORNER HISTORY:

February 1855 - This corner was established by Hiram Taylor, Deputy Surveyor. Taylor marked the position by "Set quarter section post in 1 foot water, no trees near, impossible to make mound."

September 2, 1966 - Set cast iron monument down 0.5'± using area resurvey. Established ties to monument.

July 2, 1984 - Found cast iron monument and updated ties.

January 7, 1991 - Found cast iron monument and updated ties.

May 8, 1992 - Found cast iron monument and updated ties.

August 30, 1996 - Found cast iron monument and updated ties.

September 1, 2000 - Found cast iron monument down. Raised and updated ties.

September 18, 2001 - Established NAD 1983 (1996 adj.) Anoka County project coordinates by static GPS methods.

April 18, 2011 - Found cast iron monument and updated ties.

April 18, 2013 - Found cast iron monument broken. Set construction ties, checked position by VRS GPS methods and updated corner ties prior to construction. Removed monument.

May 17, 2013 - Set cast iron monument down 0.4'± in dirt road after construction. Updated ties.

March 22, 2017 - Found cast iron monument down 0.4'±. Verified position by VRS GPS methods. Updated ties.

April 13, 2021 - Found cast iron monument down 0.4'±. Verified position by VRS GPS methods. Updated ties.