

CERTIFICATE OF LOCATION OF GOVERNMENT CORNER

County of Anoka

State of Minnesota


West 1/4 Corner of Sec. 24 Township 32 Range 23

On the 2nd day of December, 1965, the described corner was evidenced by area resurvey

and to perpetuate the location of said corner, at the exact location thereof, a permanent marker was placed consisting of 2" square steel Telespar monument with "County Surveyor" cap and a sign and post on the north side.

AND on the 5th day of April, 2021, said permanent marker was found up 0.4'± and the ties were updated

Updated reference ties are as shown below.

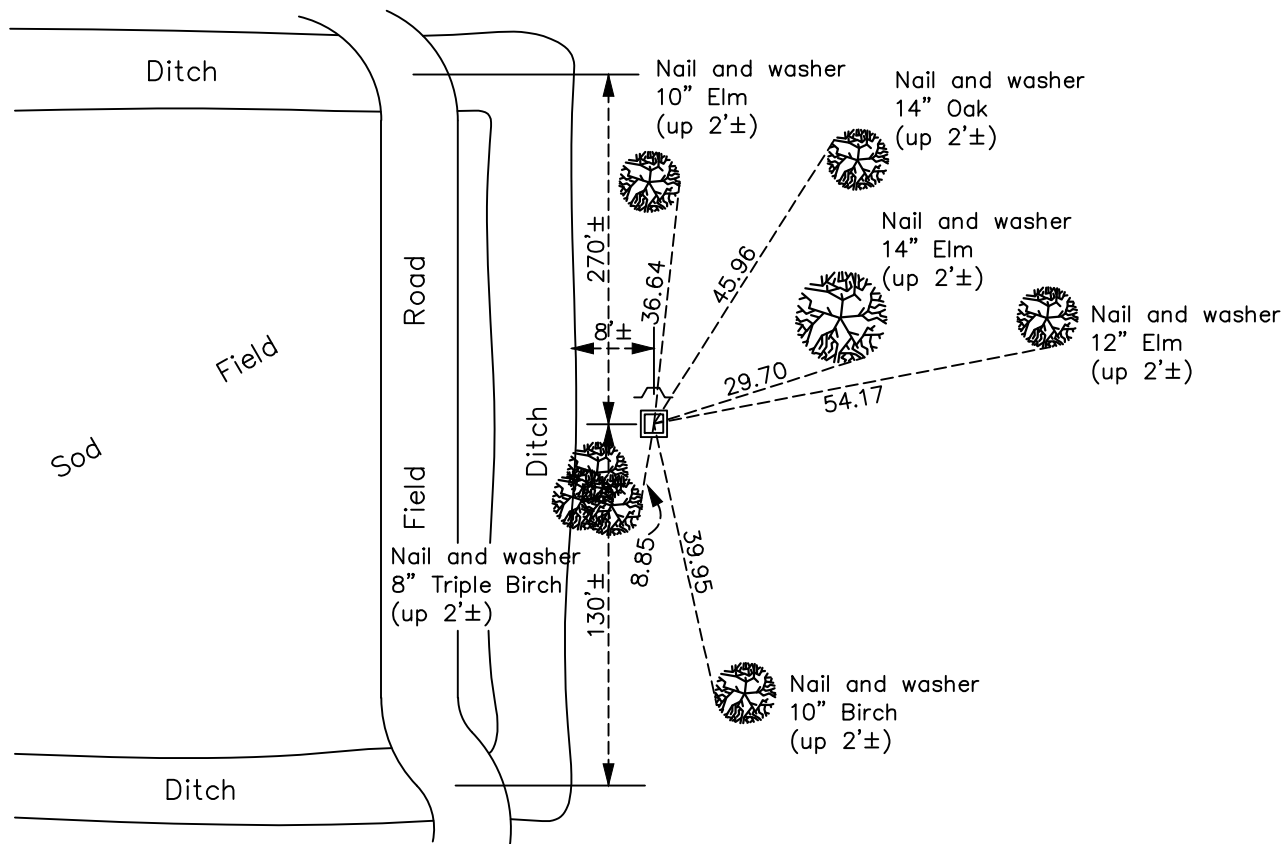

Revision Date
7/23/2021

N.A.D. 1983 Coordinates
(1996 Adjustment)

County Project Coordinates	
Northing	<u>177360.3225</u>
Easting	<u>526732.4228</u>
Date	<u>2/12/02</u>

I hereby certify that this United States public land survey monument record is correct and complete to the best of my knowledge and belief.

David Zieglmeier Date 7/21/22

David Zieglmeier Anoka County Surveyor
Minnesota License Number 46179

HISTORY OF GOVERNMENT CORNER

Page No. 87

County of Anoka

State of Minnesota

West 1/4 Corner of Sec. 24 Township 32 Range 23

CORNER HISTORY:

February 1855 - This corner was established by Hiram Taylor, Deputy Surveyor. Taylor marked the position by "Set quarter section post" with one bearing tree marked as an accessory.

December 2, 1965 - Set 1" red and white iron pipe up 3'± using area resurvey. Established ties to iron pipe.

January 21, 1974 - Found 1" red and white iron pipe and updated ties.

March 10, 1987 - Found red and white iron pipe and replaced with a cast iron monument flush. Set sign and post on the north side. Updated ties.

September 4, 1996 - Found cast iron monument and updated ties.

February 12, 2002 - Found cast iron monument and updated ties. Established NAD 1983 (1996 adj.) Anoka County project coordinates by static GPS methods.

March 31, 2011 - Found cast iron monument up 0.5'± and leaning northeasterly. Checked corner ties.

April 14, 2011 - Found cast iron monument and checked position by static GPS methods.

May 23, 2011 - Removed cast iron monument and replaced with a 2" square steel Telspar monument w/punch marked 'County Surveyor' cap up 0.4'±. Verified position by VRS GPS methods. Updated ties.

March 13, 2017 - Found 2" square steel Telspar monument w/punch marked 'County Surveyor' cap up 0.4'± and updated ties.

April 5, 2021 - Found 2" square steel Telspar monument w/punch marked 'County Surveyor' cap up 0.4'± and updated ties.