

CERTIFICATE OF LOCATION OF GOVERNMENT CORNER

County of Anoka

State of Minnesota


East 1/4 Corner of Sec. 30 Township 32 Range 23

On the 12th day of September, 1960, the described corner was evidenced by a concrete monument

and to perpetuate the location of said corner, at the exact location thereof, a permanent marker was placed consisting of a cast iron monument

AND on the 14th day of April, 2021, said permanent marker was found up 0.2'± and the ties were updated

Updated reference ties are as shown below.

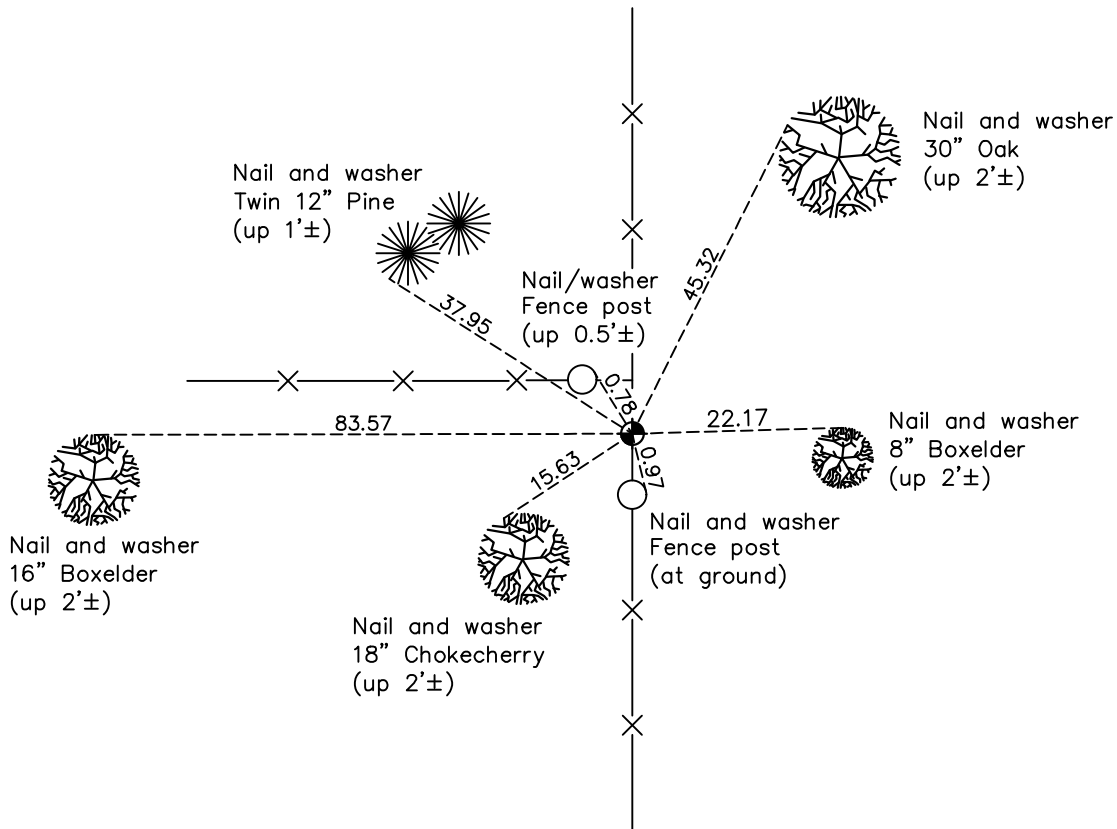

Revision Date
7/26/2021

N.A.D. 1983 Coordinates
(1996 Adjustment)

County Project Coordinates	
Northing	<u>172215.4195</u>
Easting	<u>505509.2546</u>
Date	<u>12/20/01</u>

I hereby certify that this United States public land survey monument record is correct and complete to the best of my knowledge and belief.

David Zieglmeier Date 7/21/22

David Zieglmeier Anoka County Surveyor
Minnesota License Number 46179

HISTORY OF GOVERNMENT CORNER

Page No. 102

County of Anoka

State of Minnesota

East 1/4 Corner of Sec. 30 Township 32 Range 23

CORNER HISTORY:

February 1855 - This corner was established by Hiram Taylor, Deputy Surveyor. Taylor marked the position by "Set quarter section post" with two bearing trees marked as accessories.

October 27, 1943 - Harvey Cartwright found an iron and old bearing trees. Replaced iron with a concrete monument and updated ties.

September 12, 1960 - Found concrete monument flush with an iron pipe up 6" on the west side. Updated ties.

July 22, 1964 - Found concrete monument and updated ties.

August 10, 1966 - Found concrete monument and updated ties.

June 11, 1971 - Found concrete monument and updated ties.

June 24, 1975 - Found concrete monument and replaced with a cast iron monument up 0.2'±. Updated ties.

June 19, 1978 - Found cast iron monument and updated ties.

July 10, 1981 - Found cast iron monument and updated ties.

July 11, 1984 - Found cast iron monument and updated ties.

July 14, 1987 - Found cast iron monument and updated ties.

August 15, 1996 - Found cast iron monument and updated ties.

December 20, 2001 - Found cast iron monument and updated ties. Established NAD 1983 (1996 adj.) Anoka County project coordinates by static GPS methods.

April 7, 2011 - Found cast iron monument up 0.2'± and updated ties.

March 16, 2017 - Found cast iron monument and updated ties.

April 14, 2021 - Found cast iron monument and updated ties. Verified position of corner by VRS GPS method.