

# CERTIFICATE OF LOCATION OF GOVERNMENT CORNER

County of Anoka

State of Minnesota


## Northeast Corner of Sec. 36 Township 32 Range 23

On the 11th day of November, 1975, the described corner was evidenced by area resurvey

and to perpetuate the location of said corner, at the exact location thereof, a permanent marker was placed consisting of a red and white iron pipe

AND on the 16th day of March, 2022, said permanent marker was found up 2.5'± with a sign attached facing south and the ties were updated

Updated reference ties are as shown below.

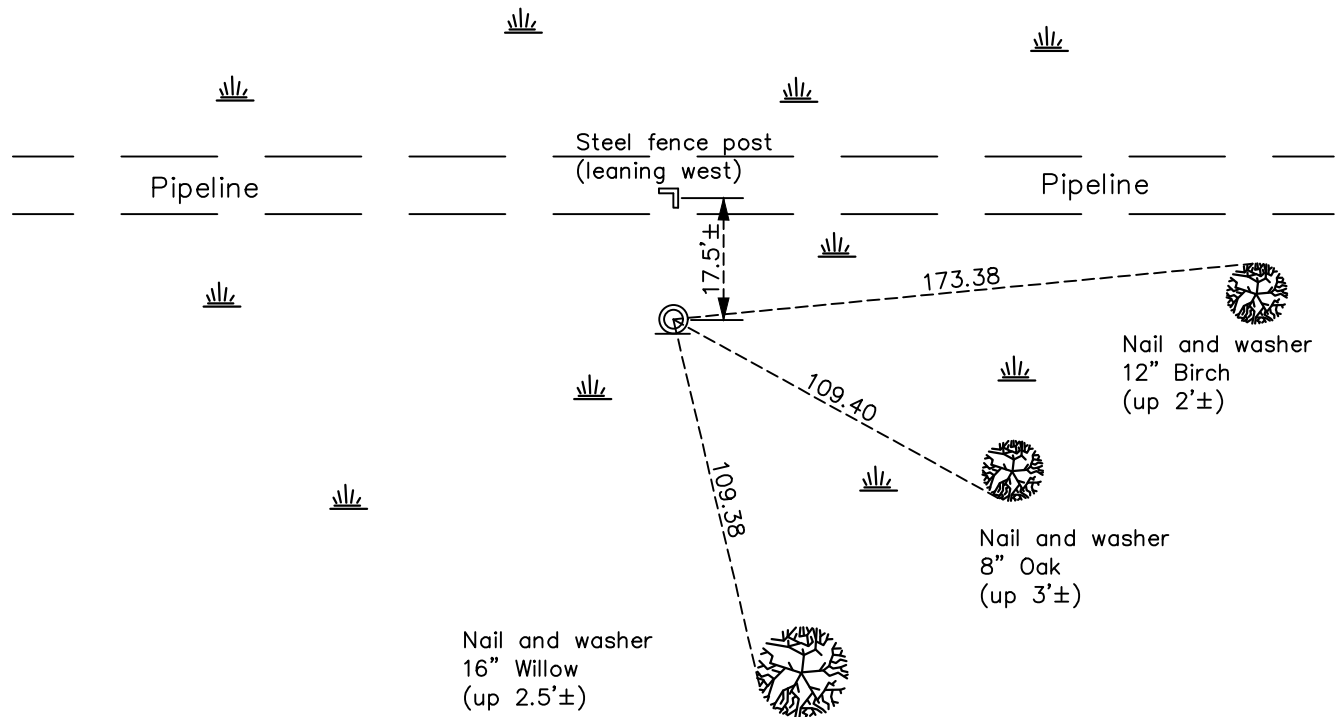

Revision Date  
 03/18/22

N.A.D. 1983 Coordinates  
 (1996 Adjustment)

| County Project Coordinates |             |
|----------------------------|-------------|
| Northing                   | 169385.3701 |
| Easting                    | 531972.0633 |
| Date                       | 2/14/02     |

I hereby certify that this United States public land survey monument record is correct and complete to the best of my knowledge and belief.

*David Zieglermeier* Date 12/11/23

David M. Zieglermeier, Anoka County Surveyor  
 Minnesota License Number 46179

# HISTORY OF GOVERNMENT CORNER

Page No. 108

County of Anoka

State of Minnesota

## Northeast Corner of Sec. 36 Township 32 Range 23

### **CORNER HISTORY:**

11/18/1975, 2/11/1994, 3/07/2011 - Found red and white iron pipe up 3.5'± and updated the ties.

February 6, 2018 - Found red and white iron pipe up 2.5'± with a sign attached facing south and the ties were updated.

March 16, 2022 - Found red and white iron pipe up 2.5'±. Position verified by VRS GPS methods. Updated ties.