
CERTIFICATE OF LOCATION OF GOVERNMENT CORNER County of Anoka State of Minnesota
<u>Northeast</u> Corner of Sec. <u>33</u> Township <u>32</u> Range <u>23</u>
On the <u>23rd</u> day of <u>July</u> , <u>1964</u> , the described corner was evidenced by <u>a granite</u>
monument
and to perpetuate the location of said corner, at the exact location thereof, a permanent marker
was placed consisting of a 2" square steel Telespar monument with a punch marked
'County Surveyor' cap. Sign and post on west side.
AND on the <u>6th</u> day of <u>April</u> , 2021, said permanent marker was found up 0.5' \pm and
the ties were updated.

Page No. 114

INDEX 806

Updated reference ties are as shown below.

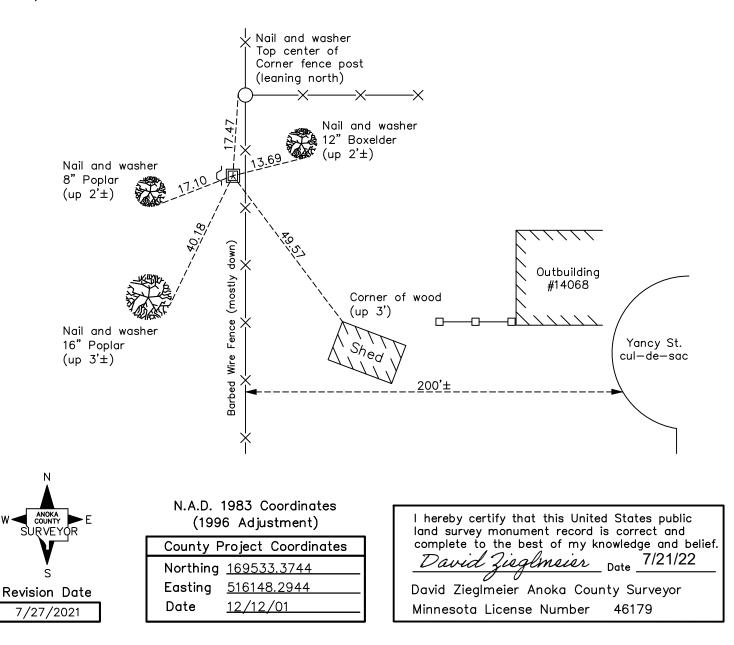

Page No. 114

HISTORY OF GOVERNMENT CORNER

County of Anoka

State of Minnesota

Northeast Corner of Sec. <u>33</u> Township <u>32</u> Range <u>23</u>

CORNER HISTORY:

February 1855 - This corner was established by Hiram Taylor, Deputy Surveyor. Taylor marked the position by "Set post corner to sections 27, 28, 33 & 34" with one bearing tree marked as an accessory.

August 31, 1955 - F.C. Jackson found a granite monument up 1'± and 7' west of a fence line. Updated the ties.

July 23, 1964 - Found granite monument up 1'± and updated ties.

August 4, 1966 - Found granite monument and updated ties.

June 23, 1971 - Found granite monument and updated ties.

June 20, 1975 - Found granite monument and updated ties.

December 10, 1975 - Replaced granite monument with a red and white iron pipe up 2.5'±. Updated ties.

June 20, 1978 - Found red and white iron pipe and updated ties.

July 11, 1984 - Found red and white iron pipe and updated ties.

July 14, 1987 - Found red and white iron pipe and updated ties.

January 29, 1991 - Found red and white iron pipe and updated ties.

November 26, 1991 - Found red and white iron pipe and updated ties.

August 13, 1996 - Found red and white iron pipe and updated ties.

December 12, 2001 - Found red and white iron pipe w/sign and updated ties. Established NAD 1983 (1996 adj.) Anoka County project coordinates by static GPS methods.

March 8, 2011 - Found red and white iron pipe leaning southwesterly 0.8'±. Set temporary point and checked ties.

March 31, 2011 - Set 2" square by 6' steel Telspar monument with punch marked 'County Surveyor' cap up 0.5'± using static GPS methods. Verified position by VRS GPS methods. Updated ties.

February 7, 2017 - Found 2" square steel Telspar monument w/cap up 0.5'±. Updated ties.

April 6, 2021 - Found 2" square steel Telspar monument w/cap up 0.5'±. Updated ties.