

CERTIFICATE OF LOCATION OF GOVERNMENT CORNER

County of Anoka

State of Minnesota

CENTER Corner of Sec. 33 Township 32 Range 23I hereby certify that on the 25 day of JULY, 1960, I found the described corner which was evidenced by IRON PIPEand I further certify that to perpetuate the location of said corner, I did, at the exact location thereof, place a permanent marker consisting of SAME

which reference or witness monuments are located in the manner following:

1-13-2021


SS

NO BEEP

4 TIES ARE

ALL GONE

BUT THE CHURCH

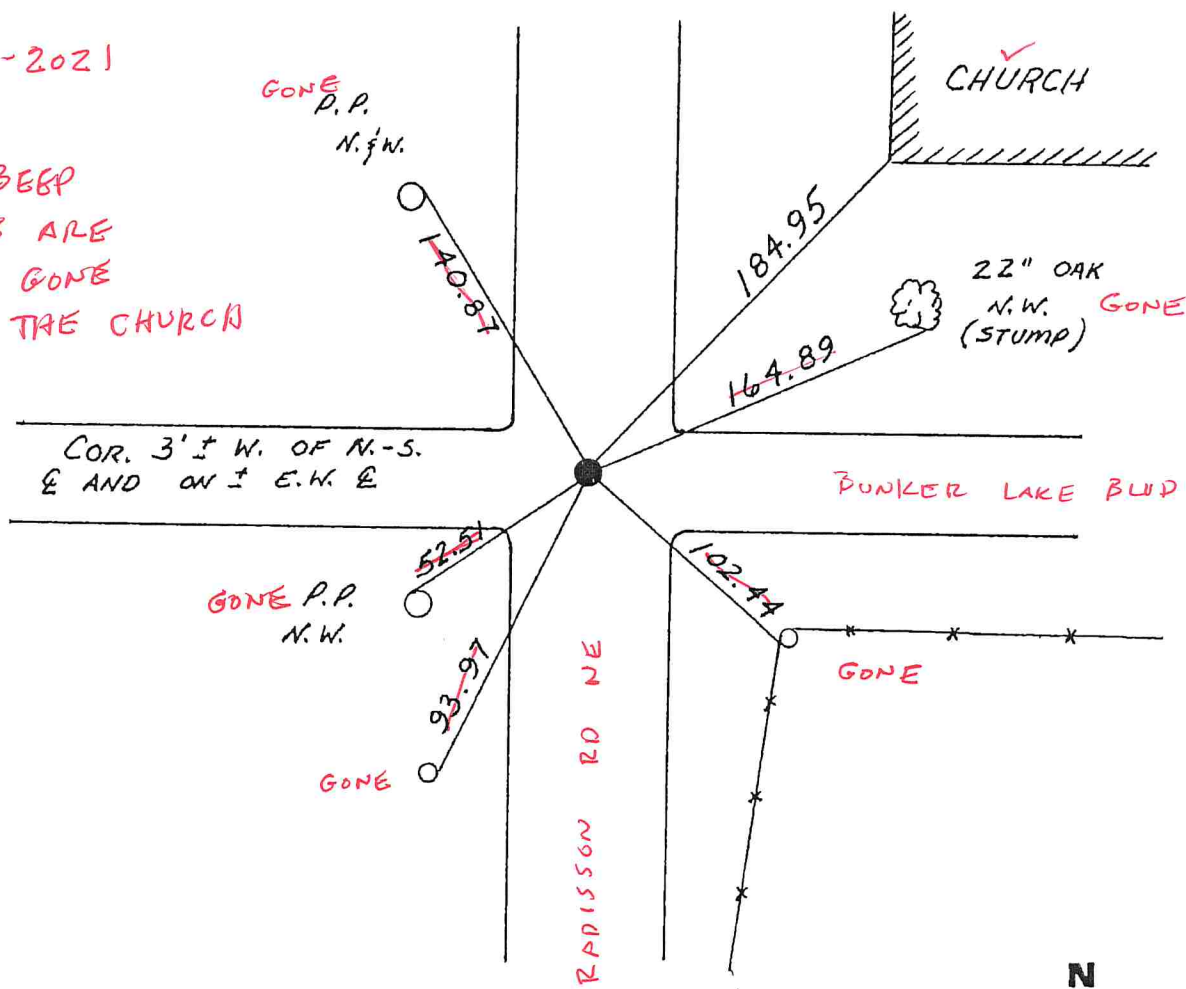

Revised date Revised date Revised date

6-29-81		

