

CERTIFICATE OF LOCATION OF GOVERNMENT CORNER

County of Anoka

State of Minnesota


East 1/4 Corner of Sec. 36 Township 32 Range 23

On the 18th day of May, 1979, the described corner was evidenced by area resurvey

and to perpetuate the location of said corner, at the exact location thereof, a permanent marker was placed consisting of a red and white iron pipe with a sign attached on the north side

AND on the 9th day of March, 2022, said permanent marker was found up 3.5'± with a sign attached to the north side and the ties were updated

Updated reference ties are as shown below.

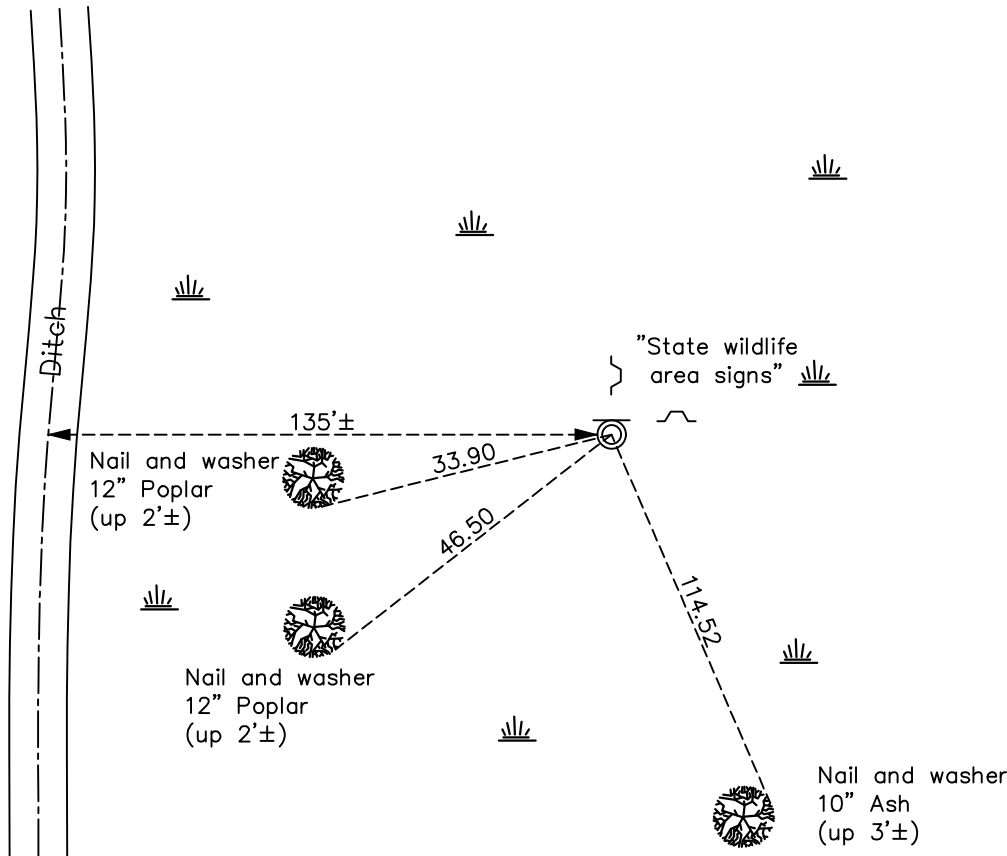

Revision Date
 03/18/22

N.A.D. 1983 Coordinates
 (1996 Adjustment)

| County Project Coordinates | |
|----------------------------|-------------|
| Northing | 166749.5217 |
| Easting | 531984.9485 |
| Date | 2/14/02 |

I hereby certify that this United States public land survey monument record is correct and complete to the best of my knowledge and belief.

David Zieglermeier Date 12/11/23

David M. Zieglermeier, Anoka County Surveyor
 Minnesota License Number 46179

HISTORY OF GOVERNMENT CORNER

Page No. 129

County of Anoka

State of Minnesota

East 1/4 Corner of Sec. 36 Township 32 Range 23

CORNER HISTORY:

11/18/1975, 5/18/1979, 3/07/2011, 2/06/2018 - Found red and white iron pipe up 3.5'± and the ties were updated.

March 9, 2022 - Found red and white iron pipe up 3.5'±. Position verified by VRS GPS methods. Updated ties.