


Js. S.H. 5-20-11

BROKEN C.I.M. DOWN 2' LEFT IN GROUND LEANING S.E.
SET NEW FULL REMOVABLE ABOVE TO STATIC POS. 0.08' N
0.08' W OF BROKEN BELOW...

TIES BELOW REFLECT NEW C.I.M. POS.

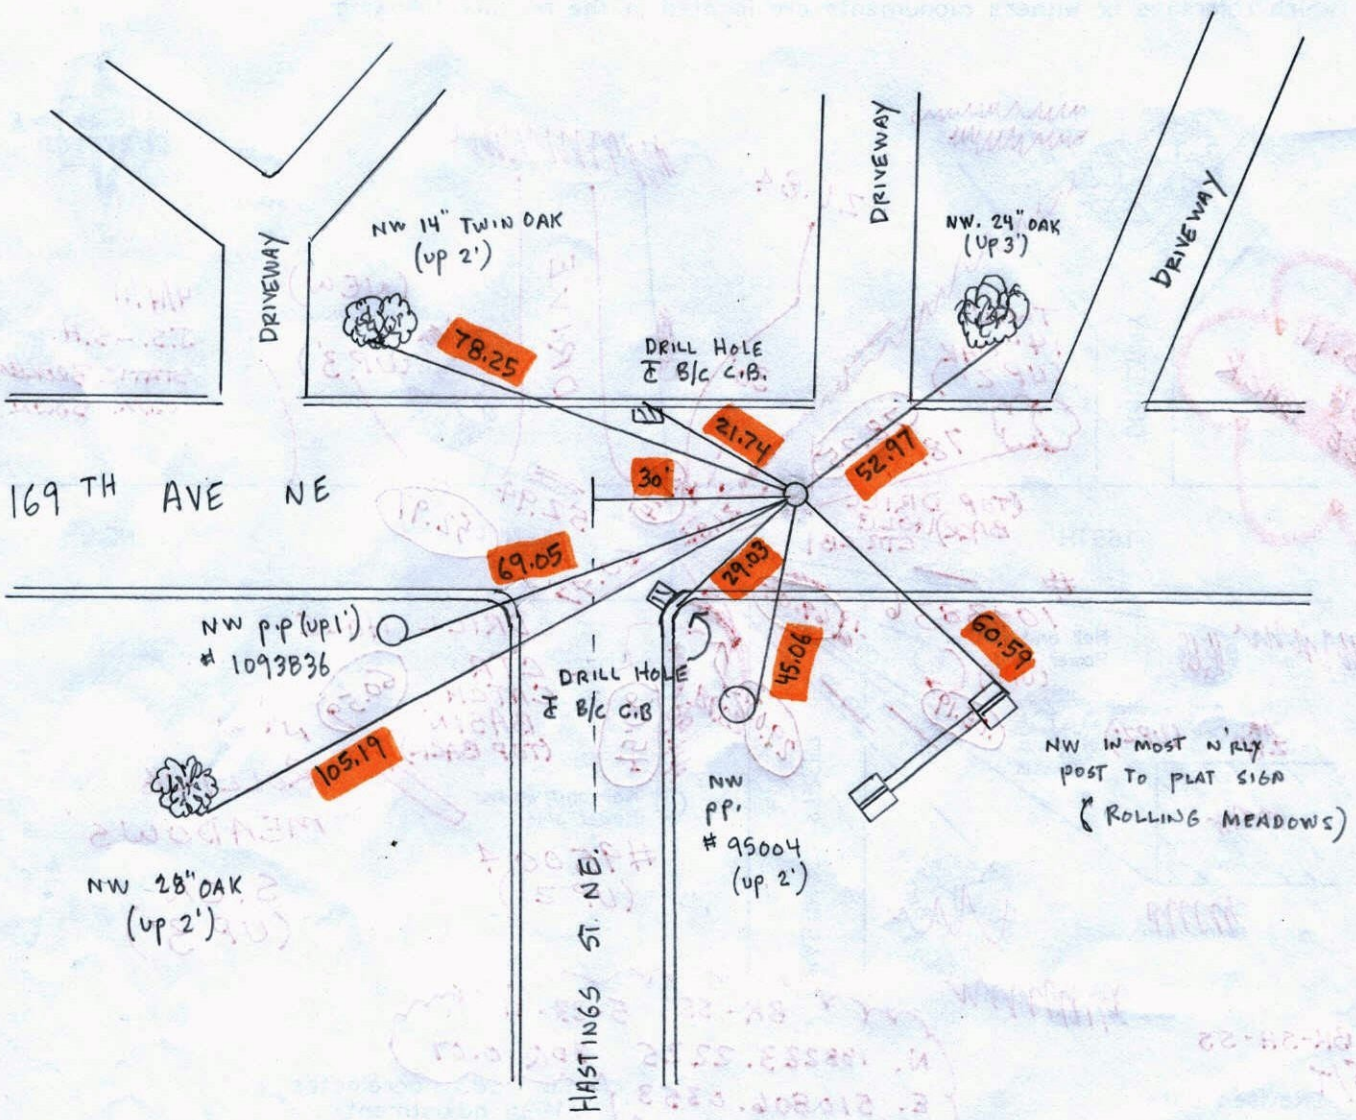

2-0-1
M-0-2
3D-0-1

CERTIFICATE OF LOCATION OF GOVERNMENT CORNER

County of Anoka


State of Minnesota

EAST ONE QUARTER Corner of Sec. 8 Township 32 Range 23

I hereby certify that on the 5 day of MARCH, 19 62, I found the described corner which was evidenced by 1" IRON PIPE


and I further certify that to perpetuate the location of said corner, I did, at the exact location thereof, place a permanent marker consisting of CAST IRON MONUMENT

which reference or witness monuments are located in the manner following:

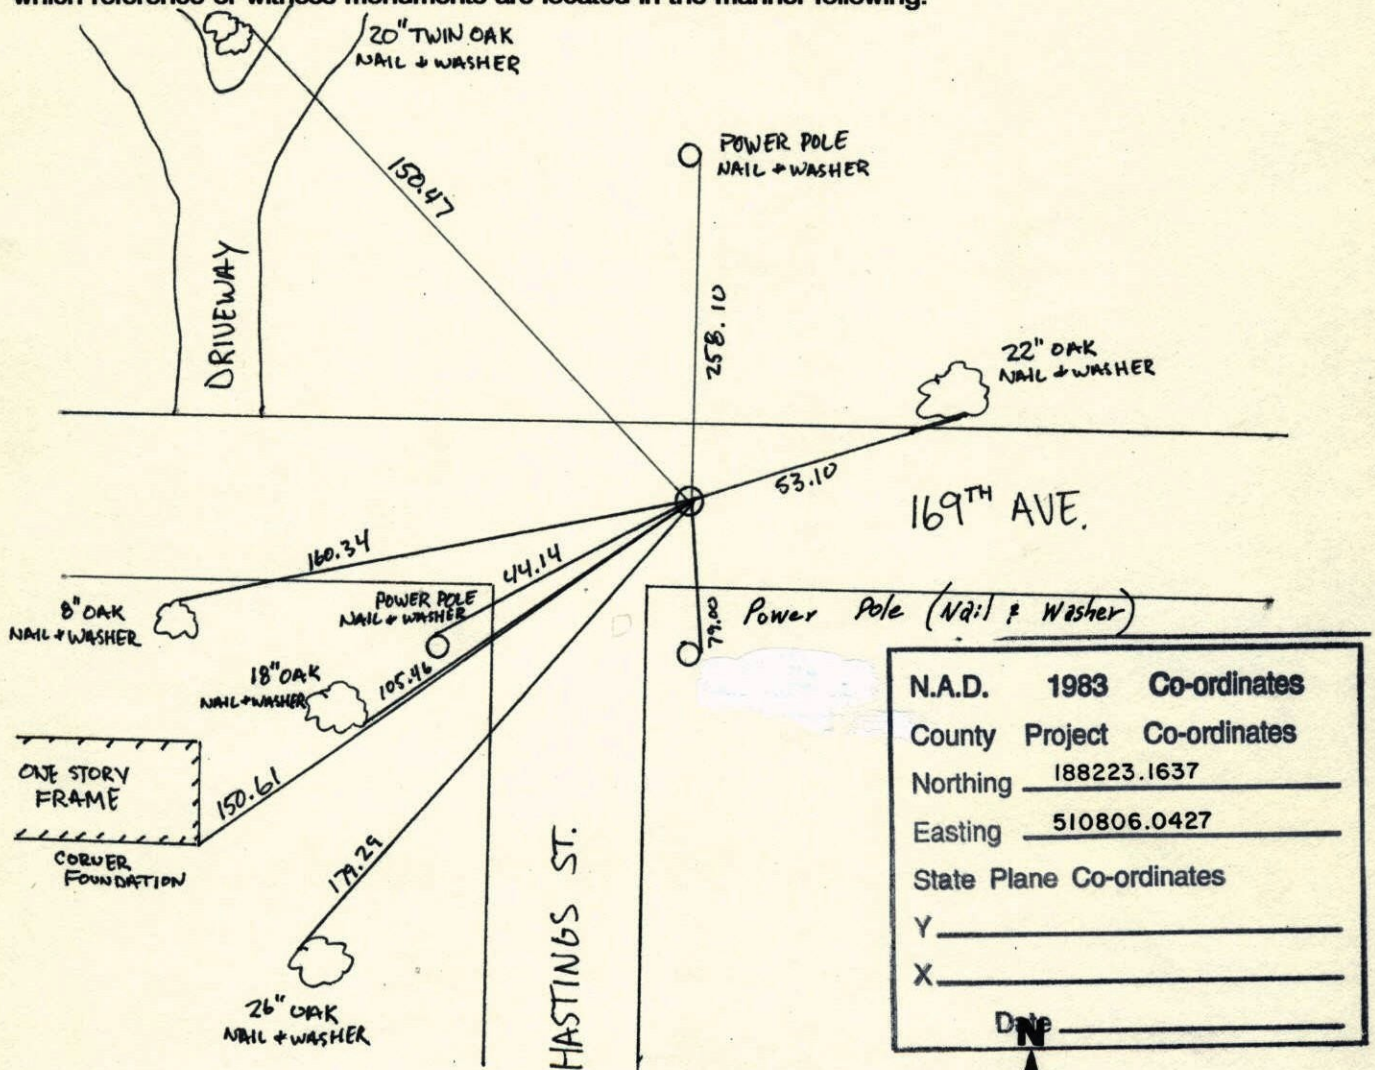


N.A.D.	1983	Co-ordinates
County	Project	Co-ordinates
Northing		<u>188223.1637</u>
Easting		<u>510806.0427</u>
State Plane Co-ordinates		
Y		_____
X		_____
Date _____		

Revised date	Revised date	Revised date
<u>10-19-91</u>		
<u>8/2/96</u>		

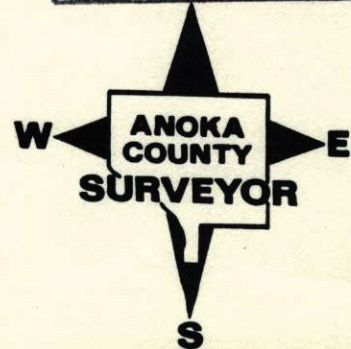


EAST QUARTER SEC. 8 TWN. 32 R-23
AREA RESURVEY
CAST IRON MON.

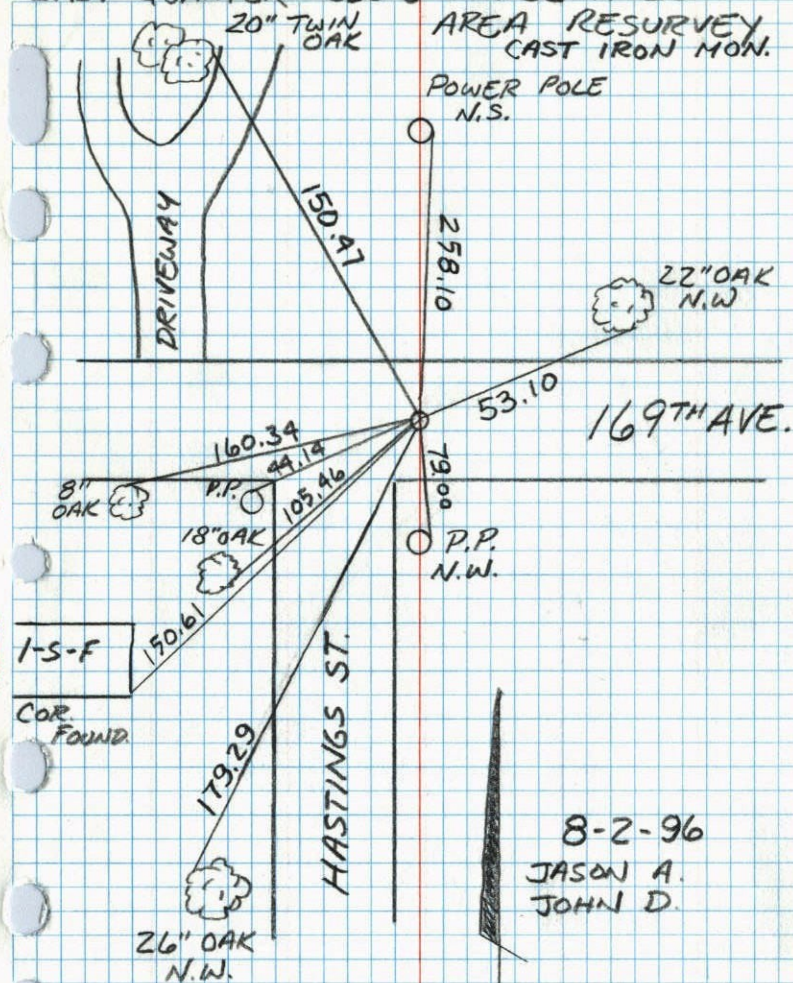

8-2-96
JASON A.
JOHN D.

E 1/4 CORNER SECTION 8 - T32 - R23

SET CAST IRON MONUMENT FLUSH IN PLACE OF
FOUND 1" IRON PIPE. PK'S 2.00' NORTH AND EAST.
5 MAR 62
J. OLIVER
J. ZOELLER

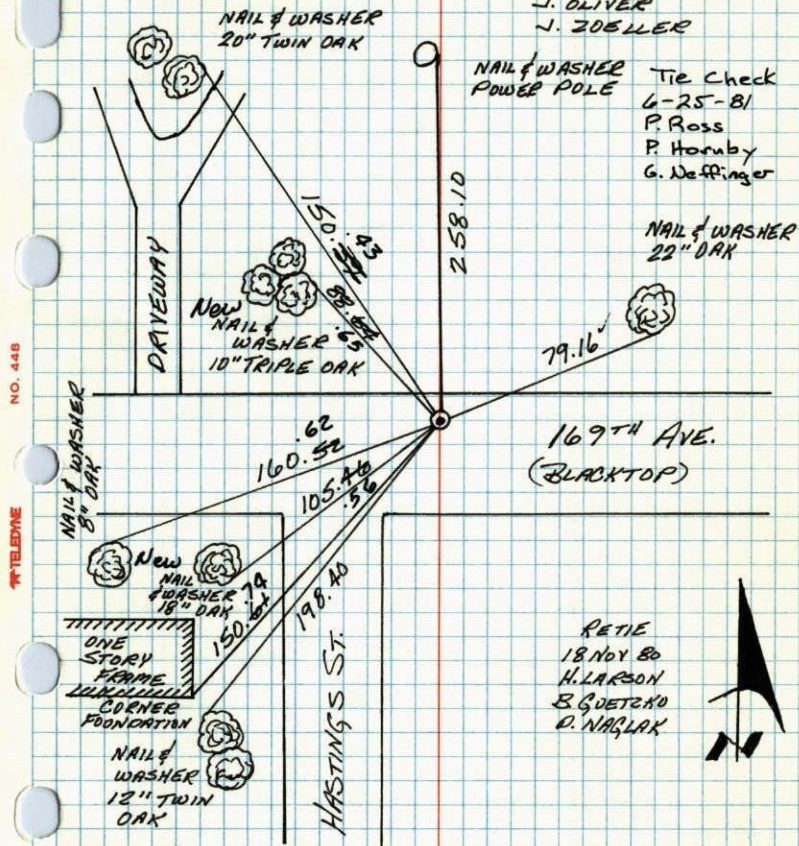

RETIE
18 NOV 80
H. LARSON
B. GUETZKO
D. WASLAK

TEMPERATURE CORRECTED
AND HORIZONTALLY
JAPED MEASUREMENTS

ROLAND W. ANDERSON
COUNTY SURVEYOR
ANOKA COUNTY, MINNESOTA

E 1/4 Cor. Sec 8-T32-R23


Found 1" Iron pipe down 3.1' Set Cast Iron Monument down 1.5±

March 5, 1962

J. Oliver
J. Zoeller

P.P.

Tie Check
June 2, 1971
R. Brien
J. Boettcher

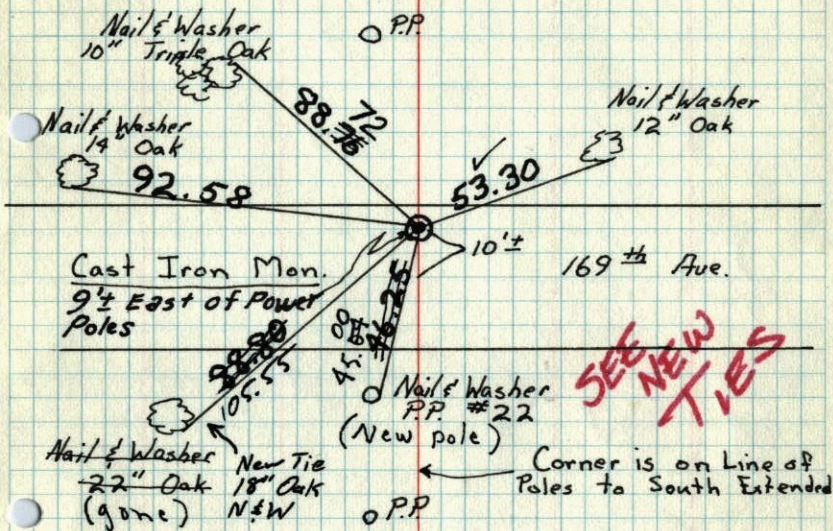

SEE NEW TIES

Cast Iron Mon.
9 1/2 East of Power Poles

169th Ave.

Nail & Washer P.P. #22 (New pole)

Corner is on Line of Poles to South Extended

Nail & Washer New Tie 22" Oak 18" Oak (gone) N&W

Tie Check June 9, 1978
D. Dahl
B. Stephens
M. H. Siron

P.P.

Replaced broken c.I. with New one.
8-22-74
H. Loxson
D. Farmer

P.P.

Tie Check June 6, 1975
D. Dahl
B. Sannerud
G. Adams

P.P.



TEMPERATURE CORRECTED AND HORIZONTALLY TAPED MEASUREMENTS

ROLAND W. ANDERSON
COUNTY SURVEYOR
ANOKA COUNTY, MINNESOTA

E 1/4 Cor. Sec. 8, T32, R23

Found 3/4" I.P. down 0.7' Found 1" Iron pipe down 3.1' Set Cast Iron down 0.5'

P.P.

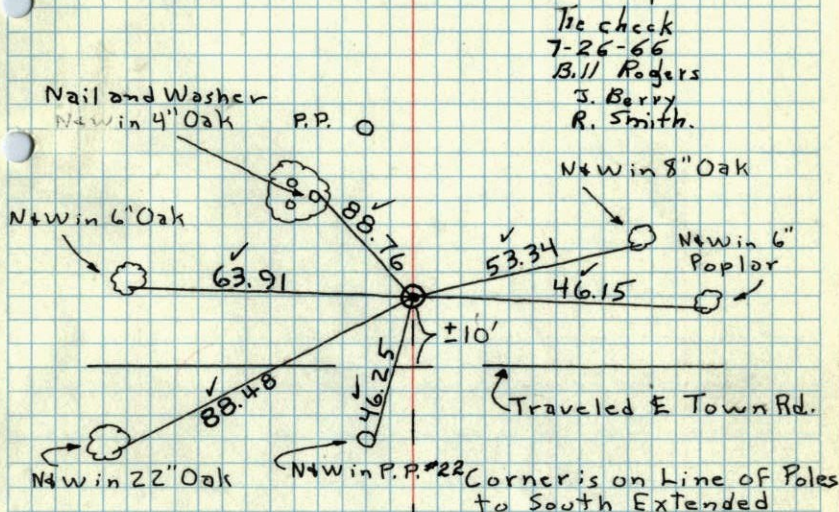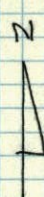

Tie check 7-26-66
B. H. Rogers
J. Berry
R. Smith.

N&W in 8" Oak

Nail and Washer New in 4" Oak

P.P.

N&W in 6" Oak

88.76

53.34

46.15

N&W in 6" Poplar

Traveled E Town Rd.

Corner is on Line of Poles to South Extended

N&W in 22" Oak

N&W in P.P. #22

Tie Check July 21, 1966
B. Rogers
J. Berry
R. Smith

P.P.

Mar. 5, 1962

J. Oliver
J. Zoeller

Retie 7/16/64

M. D. Anderson
R. Carlson

P.P.

P.P.

P.P.

TEMPERATURE CORRECTED AND HORIZONTALLY TAPED MEASUREMENTS

ROLAND W. ANDERSON
COUNTY SURVEYOR
ANOKA COUNTY, MINNESOTA