

Witness Corner W. Line Of
NE $\frac{1}{4}$ - Sec 10 - T32 - R23


Found $\frac{3}{4}$ " Iron Pipe Up 0.01' ±

Tie Check
June 8, 1978
D. Dahl
B. Stephens
M. Kilsow


Tie Check
6-25-81
P. Ross
P. Hornby
G. Neffinger

TIE CHECK
July 12, 1984
G. Lips
D. Ross
R. Bennett

Tie Check
June 7, 1975
D. Dahl
B. Sannerud
G. Adams

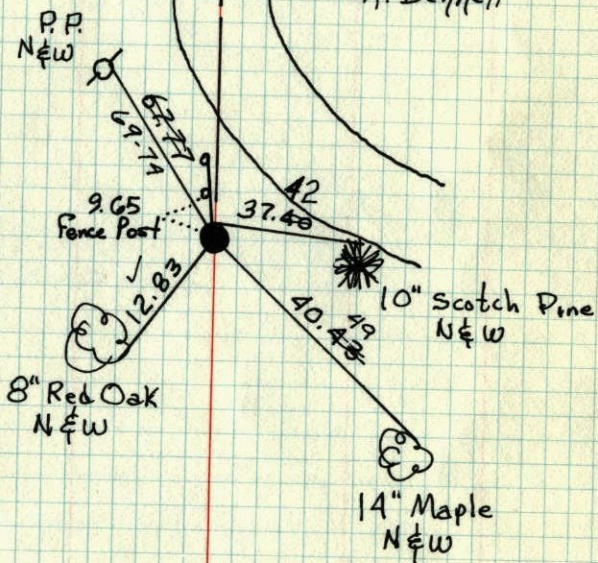


7-15-1974
R. Farmer
N. Dahl
D. Dahl
Temp. 75°
Tape #12

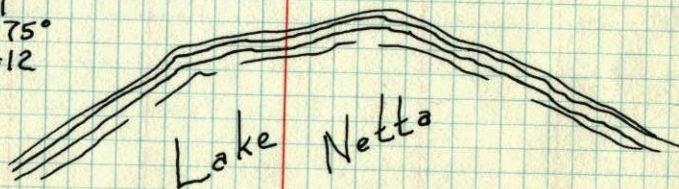

Witness corner W line of
NE $\frac{1}{4}$ Sec 10 - 32 - 23
found $\frac{3}{4}$ " Iron Pipe
up d'f

JULY 15, 1974

R. Farmer
N. Dahl
D. Dahl
75° Tape #12

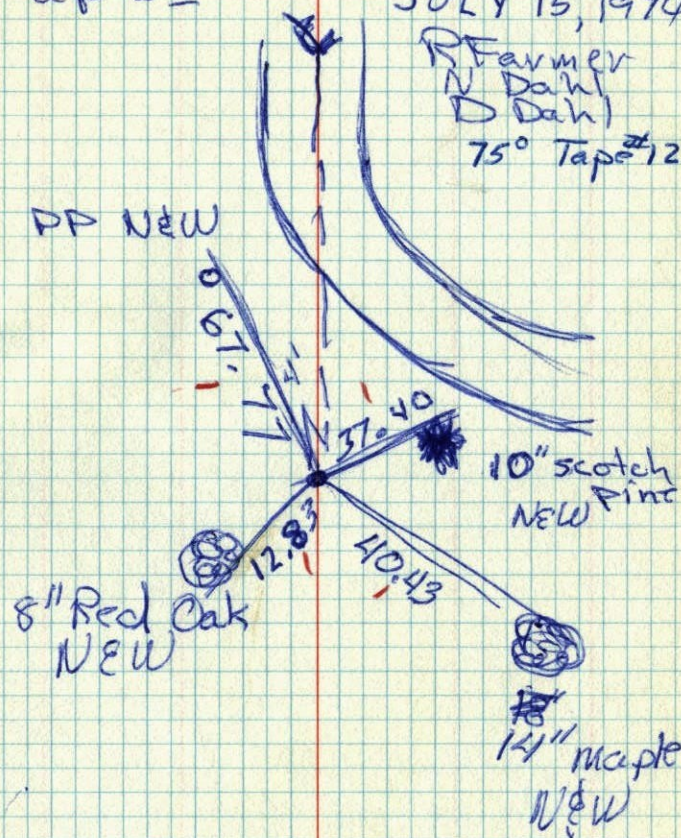

Lake Netta