


Witness Cor. on N&S 1/4 line Sec. 10-32-23

Witness Corners on both N&S of lake

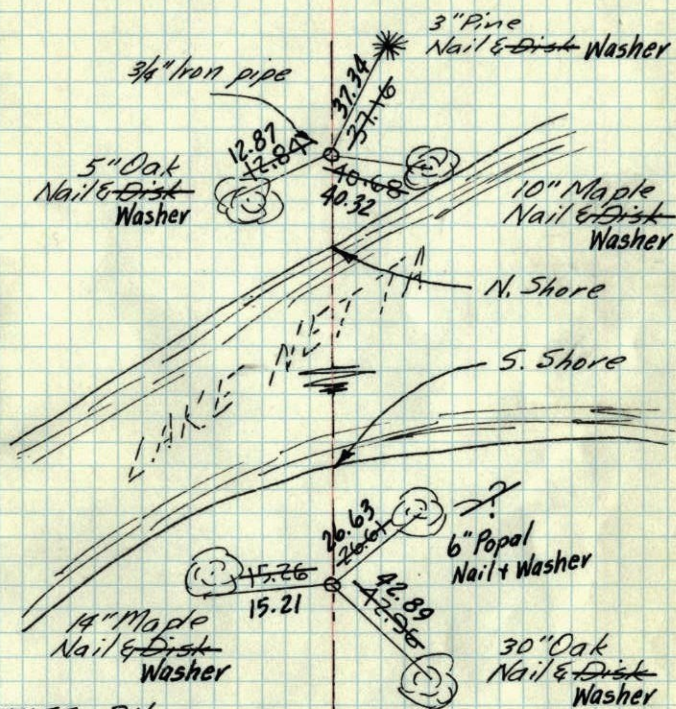

TIES BY

ROBERT M. KNUDSON  
1961

Retie 7/17/64

M. D. Anderson  
R. Carlson

Can't find  
7-13-81  
P. Ross

1961  
R.M. Knudson