





N 1/4 Cor. Sec 4 T32 R23


Cast Iron Monument Set by N.C. Hoium  
(Cast Iron Mon. is not an Anoka  
County Surveyors Mon.)

Tie Check  
June 15, 1971

R. Brien  
J. Boettcher  
B. Olson

Aug. 10, 1962

J. Oliver  
M. D. Anderson

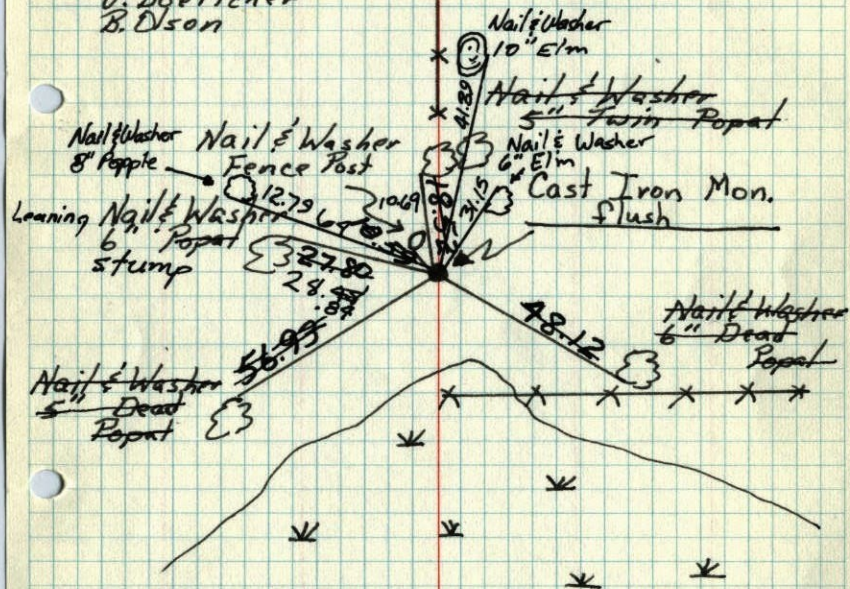

Tie Check  
July 17 1975  
D. Dahl  
B. Sannerud  
G. Adams

TIECHECK  
6-22-71  
P. ROSS  
P. HORNBY  
G. NEFFINGER

Tie check  
June 6, 1978  
D. Dahl  
J. Stephens  
M. Histon

Tie Check  
7-16-84  
G. Lips  
D. Ross  
R. Bennett

TEMPERATURE CORRECTED  
AND HORIZONTALLY  
TAPED MEASUREMENTS

ROLAND W. ANDERSON  
COUNTY SURVEYOR  
ANOKA COUNTY, MINNESOTA

N 1/4 Cor. Sec. 4, T32, R23


Found Cast Iron Monument Set by N.C. Hoium  
(Cast Iron Mon. is Not Anoka Co. Surveyors Mon.)

10 Aug 62

J. Oliver  
M. D. Anderson

Retie 7/16/64

M. D. Anderson  
R. Carlson

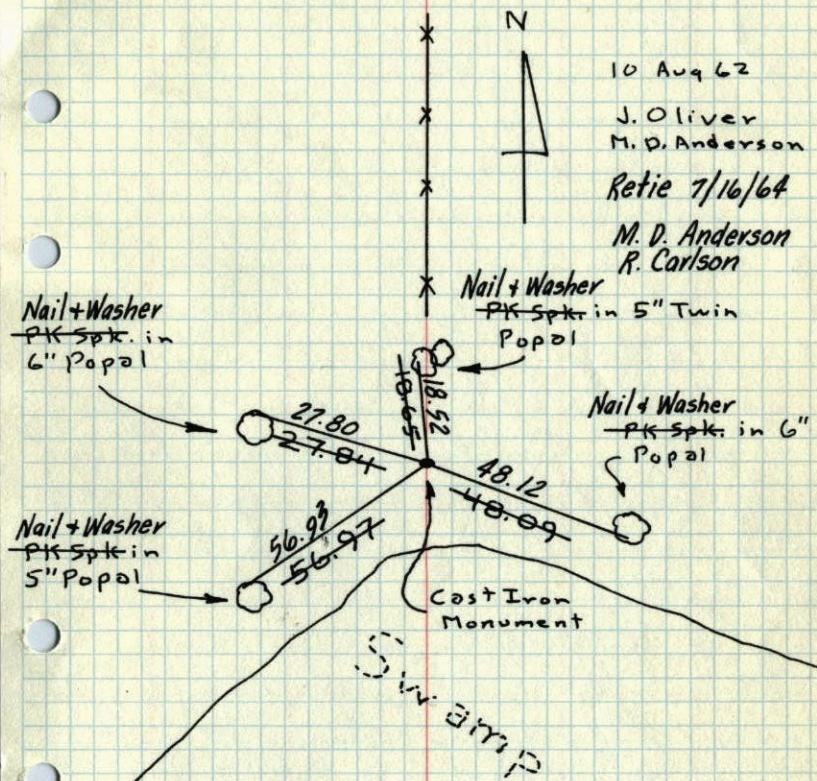

TEMPERATURE CORRECTED  
AND HORIZONTALLY  
TAPED MEASUREMENTS

ROLAND W. ANDERSON  
COUNTY SURVEYOR  
ANOKA COUNTY, MINNESOTA



N 1/4 Cor Sec. 4, T 32, R 23

Found Cast Iron Monument Set by N.C. Holm

(Cast Iron Mon. is Not Analka Co. Surveyors Mon.)

