

CERTIFICATE OF LOCATION OF GOVERNMENT CORNER

County of Anoka



State of Minnesota

West 1/4 Corner of Sec. 23 Township 32 Range 23

I hereby certify that on the 2nd day of September, 1966, I found the described corner which was evidenced by area resurvey

and I further certify that to perpetuate the location of said corner, I did, at the exact location thereof, place a permanent marker consisting of a cast iron monument ✓

which reference or witness monuments are located in the manner following:

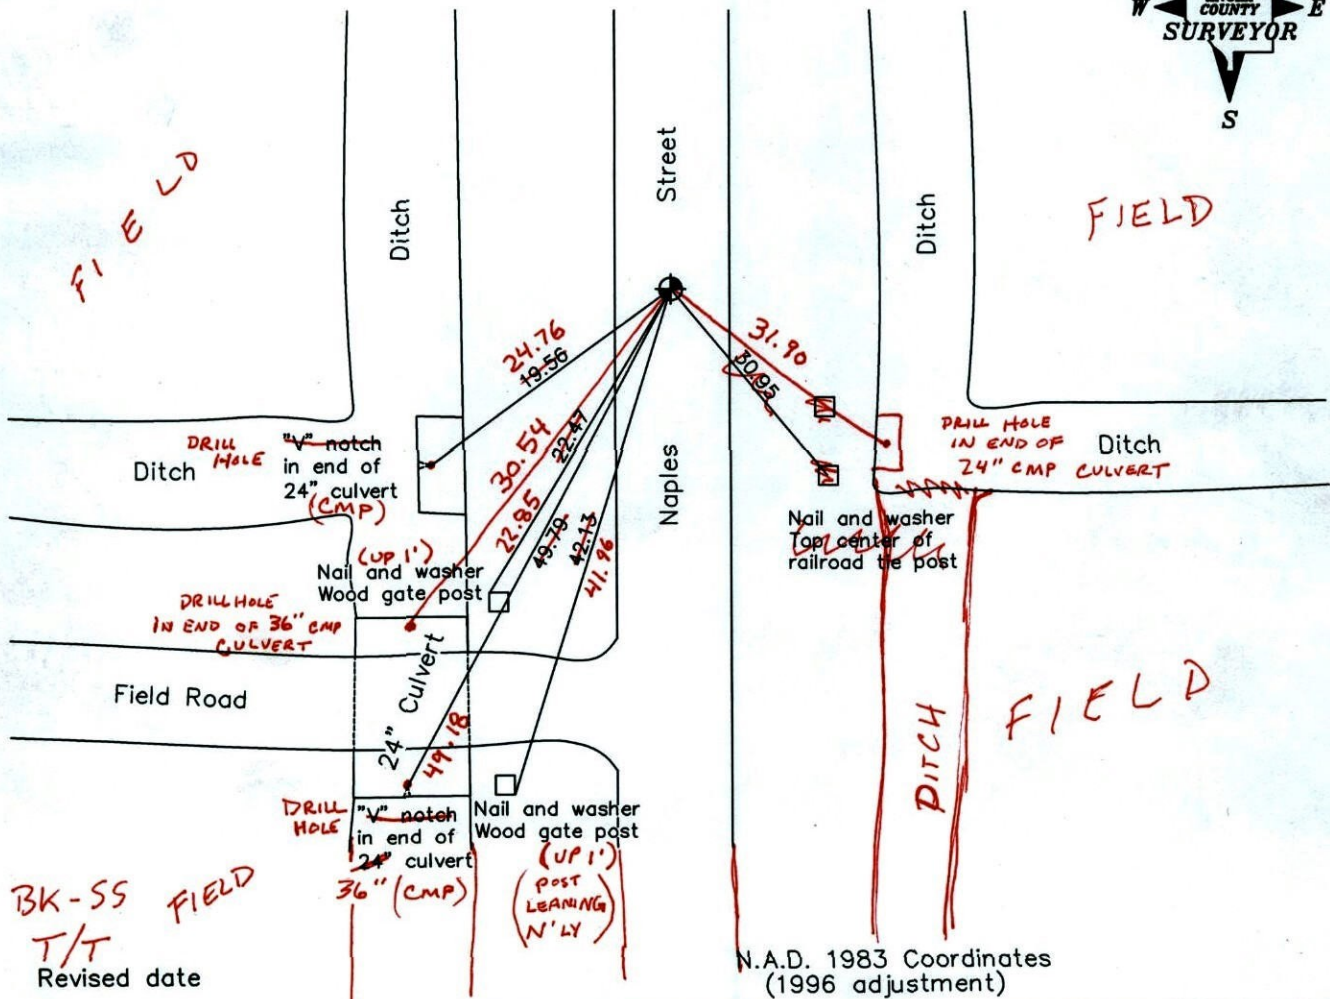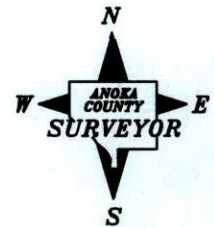

BK-SS FIELD
T/T
Revised date

N.A.D. 1983 Coordinates
(1996 adjustment)

9/01/00
9/18/01
7/27/01
4-18-11

County Project Coordinates	State Plane Coordinates
Northing <u>177385.7683</u>	Y _____
Easting <u>521432.1025</u>	X _____

Date 9/18/01

CERTIFICATE OF LOCATION OF GOVERNMENT CORNER

County of Anoka


State of Minnesota

WEST QTR. Corner of Sec. 23 Township 32 Range 23

I hereby certify that on the 2ND day of SEPTEMBER 19 66, I found the described corner which was evidenced by RESURVEY


and I further certify that to perpetuate the location of said corner, I did, at the exact location thereof, place a permanent marker consisting of CAST IRON MONUMENT

which reference or witness monuments are located in the manner following:

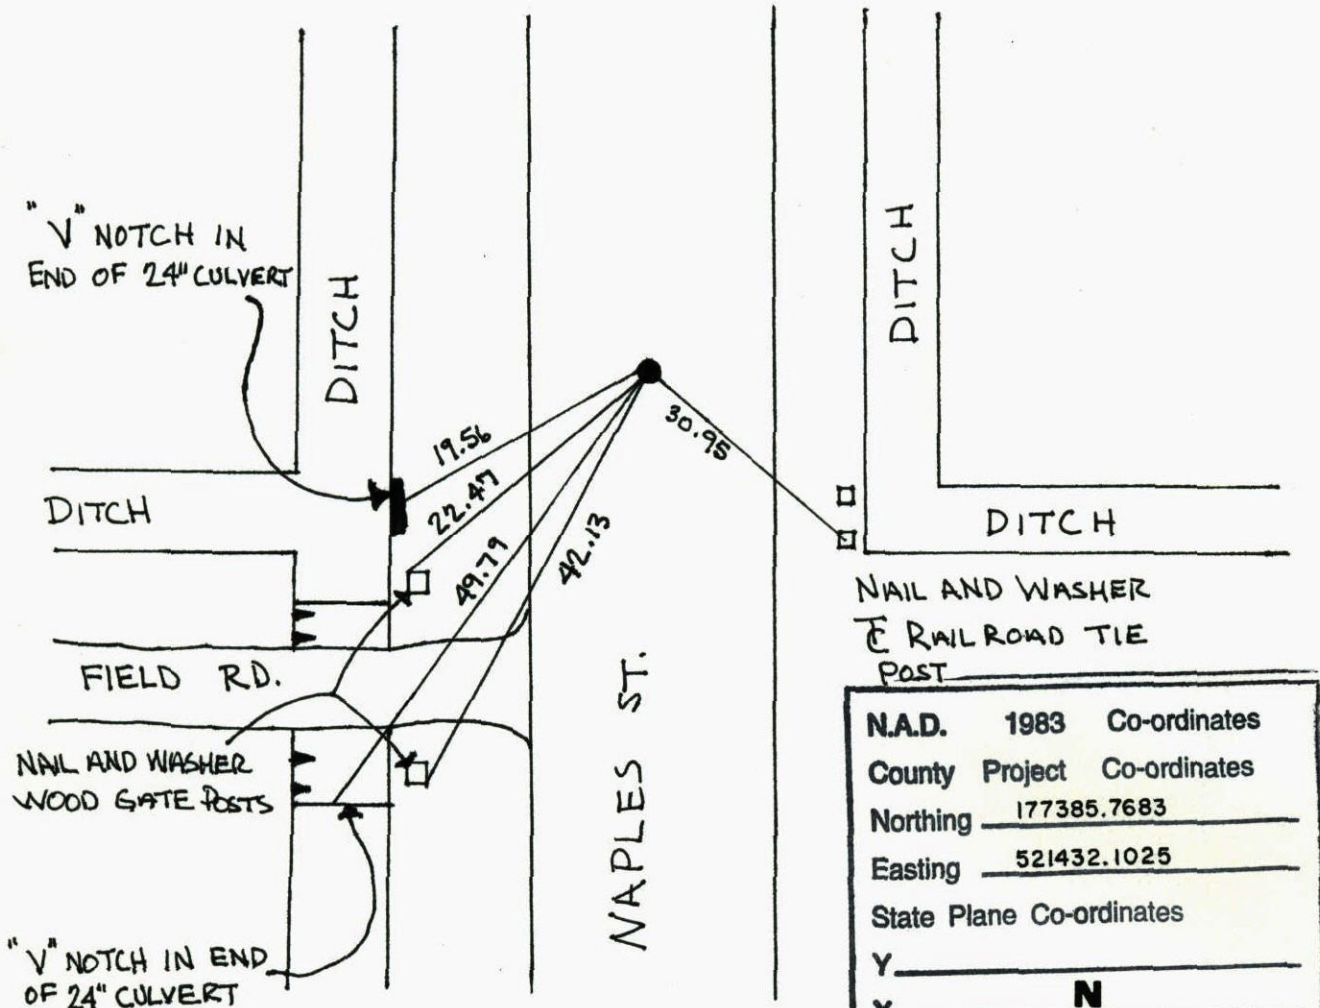


N.A.D.	1983	Co-ordinates
County	Project	Co-ordinates
Northing		<u>177385.7683</u>
Easting		<u>521432.1025</u>
State Plane Co-ordinates		
Y	<u>N</u>	
X	<u>N</u>	
Date	<u> </u>	

Revised date	Revised date	Revised date
1-7-91		
5-8-92		
8-30-96		
9-1-00		

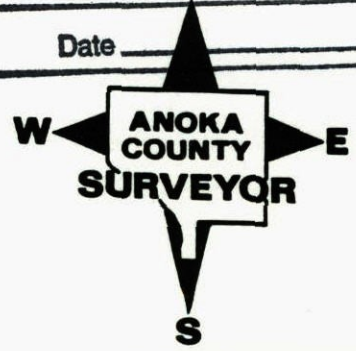

WEST QTR. COR. SEC. 23, T. 32, R. 23
RAISED AND RETIED C.I.M.

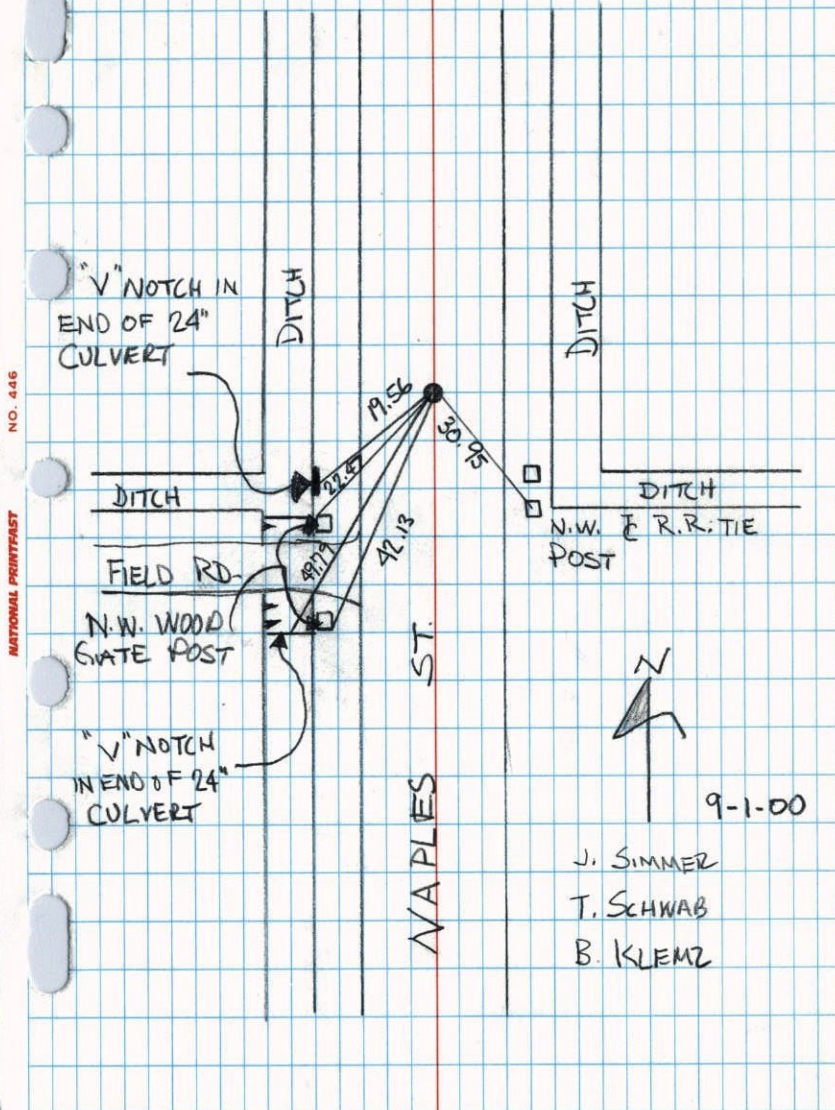

W 1/4 Cor. Sec. 23, T 32, R 23

Set C.I. Mon. from area re survey

C.I. down 0.5'±


Sept 2, 1966

M.D. Anderson

A.S. Smith

D. Powell

Temp. 81°

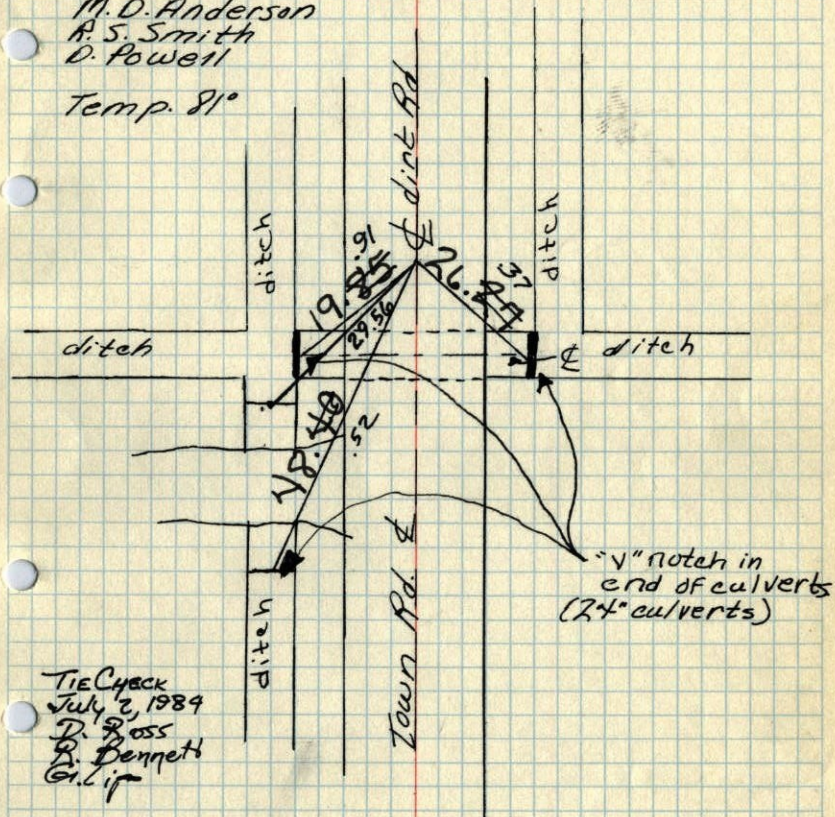


TEMPERATURE CORRECTED
AND HORIZONTALLY
TAPED MEASUREMENTS

ROLAND W. ANDERSON
COUNTY SURVEYOR
ANOKA COUNTY, MINNESOTA

W 1/4 Cor. Sec 23-T32-R23
 Set C.I. Mon. from area resurvey
 C.I. down 0.5'±

Sept. 2, 1966
 M.D. Anderson
 R. Smith
 D. Powell
 Temp 81°

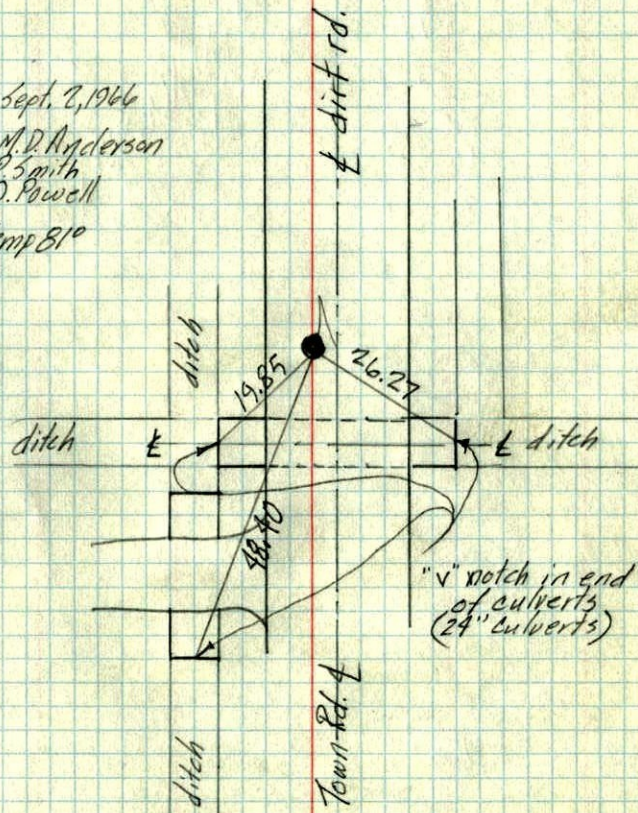

4/20