


Center of Sec. 29 T. 32 R. 23

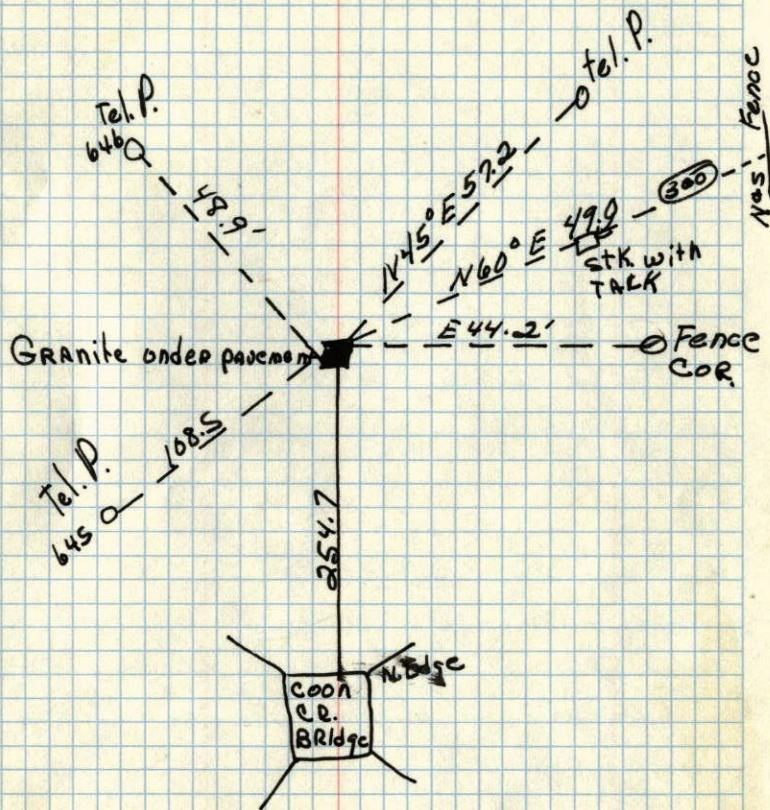

9-15-23  
 Dug up Granite & placed  
 3" x 2.0' round fence  
 post on top.