NE Sec. 16 T 32 R 23
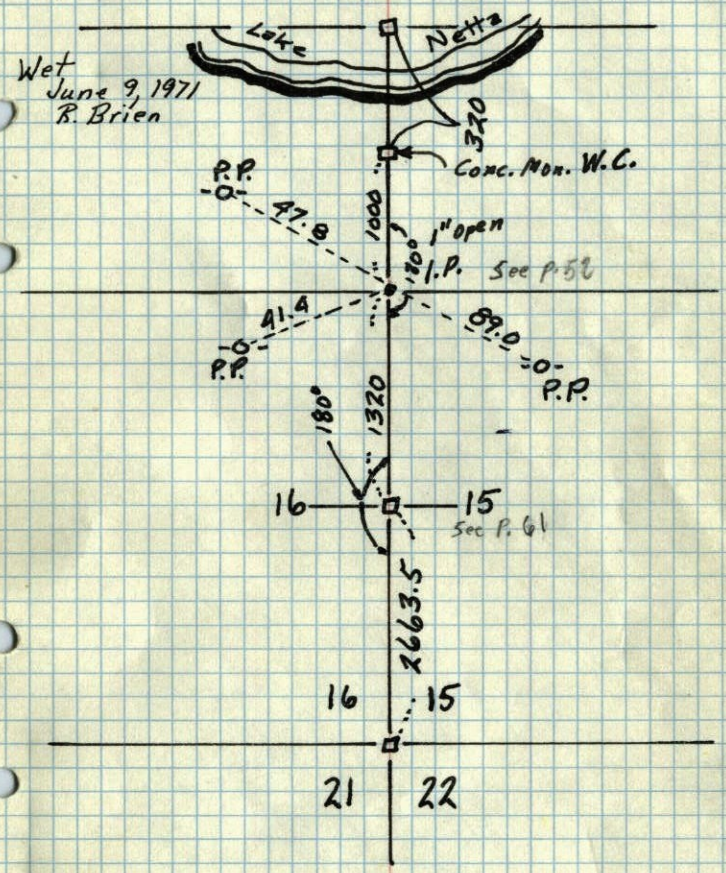
Conc. Mon
12/2/18