


N¹/₄ Cor. Sec. 28-T31-R22

Set Red+White Iron Pipe up 3.0'±.
Set from area resurvey.

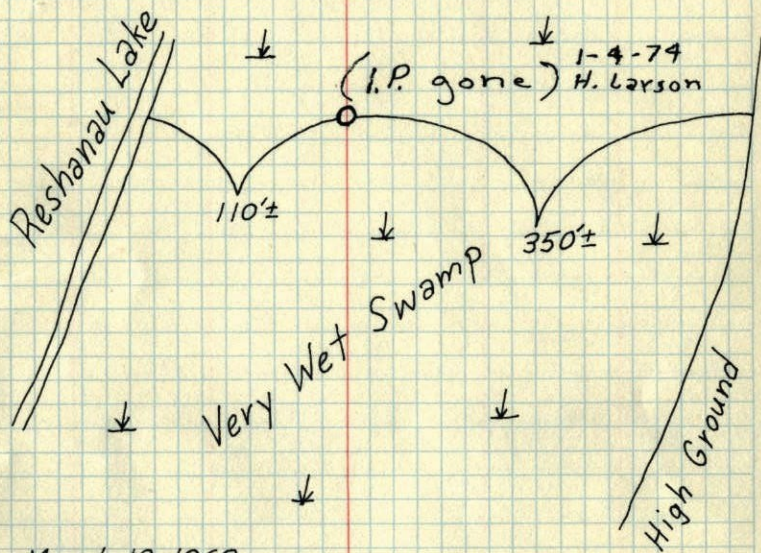

March 13, 1968
M.D. Anderson
H.J. Larson
R.A. Olson


Winter Check

TEMPERATURE CORRECTED
AND HORIZONTALLY
TAPED MEASUREMENTS

ROLAND W. ANDERSON
COUNTY SURVEYOR
ANOKA COUNTY, MINNESOTA

N¹/₄ Cor. Sec. 28-T31-R22

Set Red & White Iron pipe up 3.0'±.
Set from area resurvey

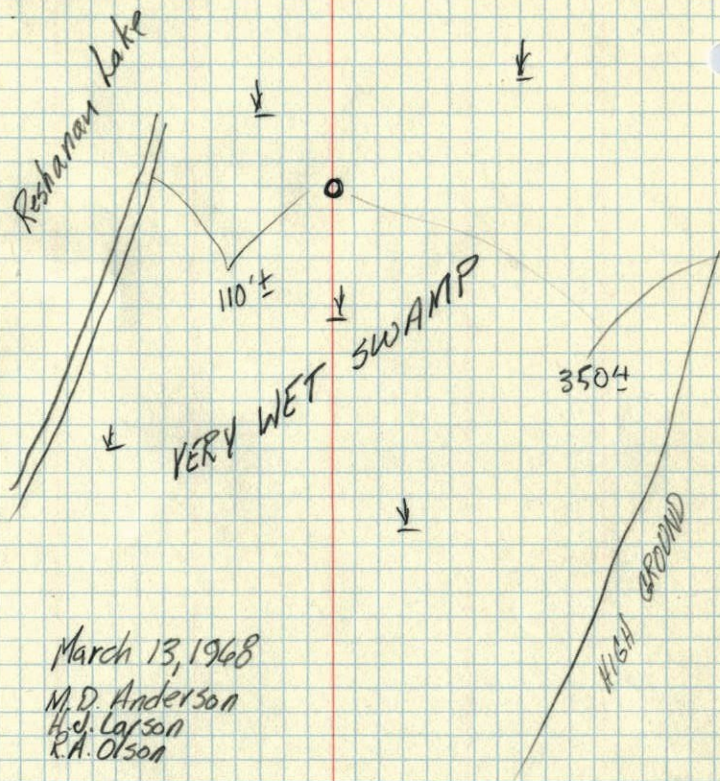

March 13, 1968
M.D. Anderson
H.J. Larson
R.A. Olson