

*lms*

# CERTIFICATE OF LOCATION OF GOVERNMENT CORNER



County of Anoka State of Minnesota

Center Corner of Sec. 36 Township 31 Range 22

I hereby certify that on the \_\_\_ day of \_\_\_\_\_, \_\_\_, I found the described corner which was evidenced by \_\_\_\_\_ (FOR REFERENCE ONLY)

and I further certify that to perpetuate the location of said corner, I did, at the exact location thereof, place a permanent marker consisting of \_\_\_\_\_

which reference or witness monuments are located in the manner following:

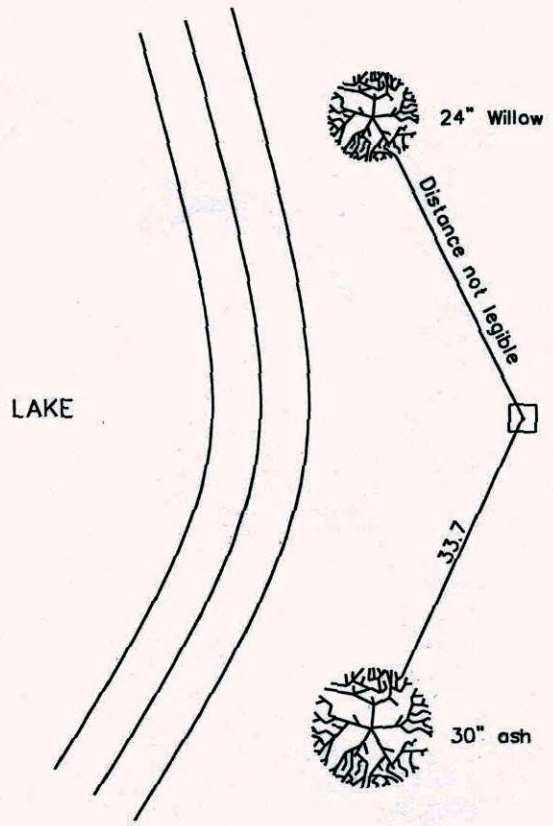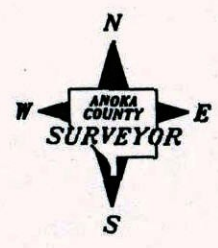

Revised date

|  |
|--|
|  |
|  |
|  |
|  |
|  |

N.A.D. 1983 Co-ordinates

| County Project Co-ordinates | State Plane Co-ordinates |
|-----------------------------|--------------------------|
| Northing _____              | Y _____                  |
| Easting _____               | X _____                  |

Date \_\_\_\_\_

# CERTIFICATE OF LOCATION OF GOVERNMENT CORNER

County of Anoka

State of Minnesota


CENTER Corner of Sec. 36 Township 31 Range 22

I hereby certify that on the \_\_\_\_\_ day of \_\_\_\_\_, 19\_\_\_\_, I found the described corner which was evidenced by \_\_\_\_\_

( FOR REFERENCE ONLY )

and I further certify that to perpetuate the location of said corner, I did, at the exact location thereof, place a permanent marker consisting of \_\_\_\_\_

which reference or witness monuments are located in the manner following:

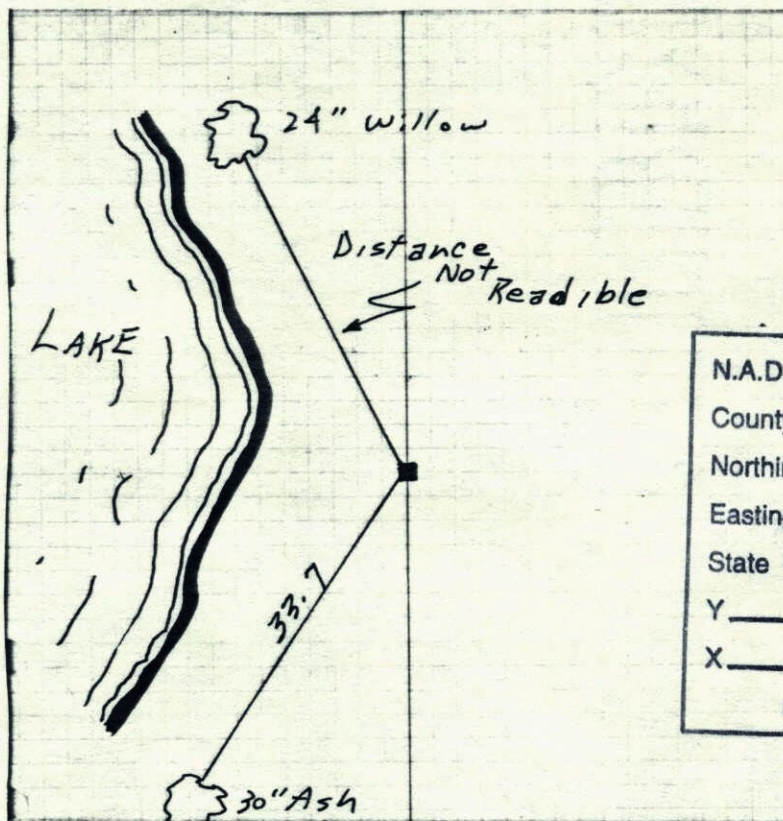

|                          |         |              |
|--------------------------|---------|--------------|
| N.A.D.                   | 1983    | Co-ordinates |
| County                   | Project | Co-ordinates |
| Northing                 | _____   |              |
| Easting                  | _____   |              |
| State Plane Co-ordinates |         |              |
| Y                        | _____   |              |
| X                        | _____   |              |
| Date                     | _____   |              |

Revised date

|  |
|--|
|  |
|  |
|  |
|  |
|  |
|  |
|  |

By

|  |
|--|
|  |
|  |
|  |
|  |
|  |
|  |
|  |


Minnesota State Plane Coordinates  
South Zone

Y \_\_\_\_\_ X \_\_\_\_\_

\_\_\_\_\_, \_\_\_\_\_  
County Surveyor Date

Registered Land Surveyor No. \_\_\_\_\_

Center Sec. 36, T31, R22

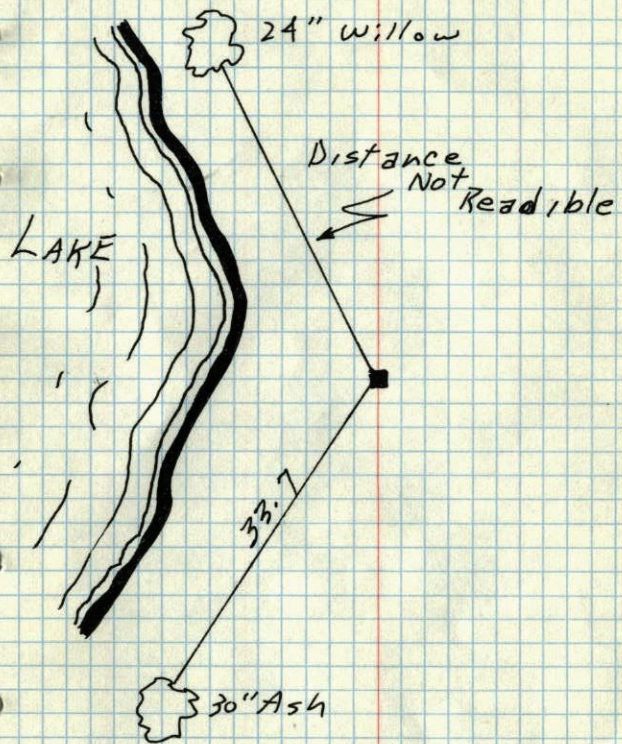Milner W. Carley  
No Date