


W 1/4 Cor. Sec. 18, T31, R22

Found 3/4" I.P. which fits old Ties good,

Removed and replaced with Cast Iron Monument.

PK Nails 2.00' North + East.

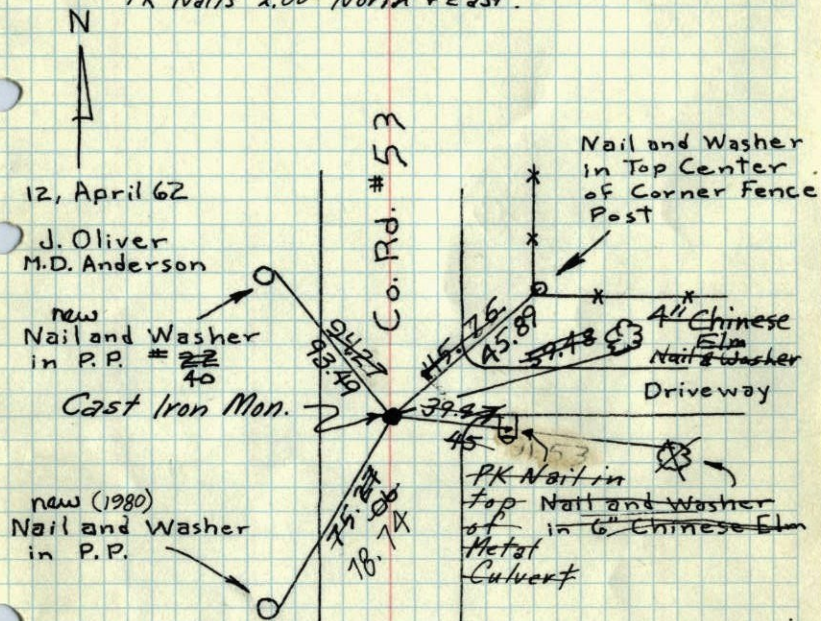

12, April 62

J. Oliver
M.D. Andersonnew
Nail and Washer
in P.P. # 22
40

Cast Iron Mon.

new (1980)
Nail and Washer
in P.P.

Tie Check

June 15, 1973

B. Olson
D. Brien
D. Farmer

TIE CHECK

8-6-80

B. STEPHENS

P. ROSS

P. HORNBY

TIE CHECK

May 19, 1977

R. JANNERUD

D. DAHL


S. BRIEN

ROLAND W. ANDERSON
COUNTY SURVEYOR
ANOKA COUNTY, MINNESOTATEMPERATURE CORRECTED
AND HORIZONTALLY
TAPED MEASUREMENTS

W 1/4 Cor. Sec. 18, T31, R22

Found 3/4" I.P. which fits old Ties good,

Removed and replaced with Cast Iron Monument.

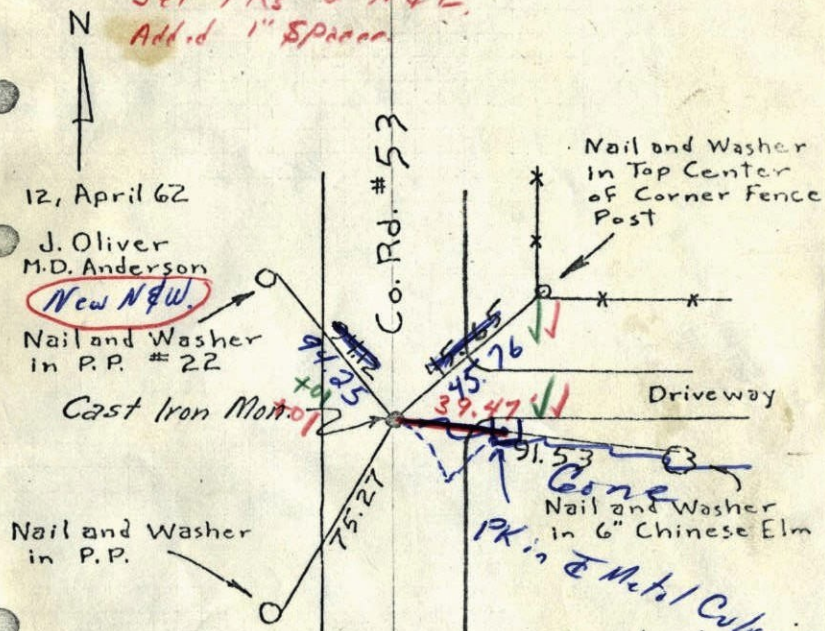Set PKs 2" N&E.
Add. 1" Spacers.

12, April 62

J. Oliver
M.D. Anderson

New N&W.

Nail and Washer
in P.P. # 22

Cast Iron Mon.

Nail and Washer
in P.P.

Tie check

June 15, 1965

M.D. Anderson
J. DunlopROLAND W. ANDERSON
COUNTY SURVEYOR
ANOKA COUNTY, MINNESOTATEMPERATURE CORRECTED
AND HORIZONTALLY
TAPED MEASUREMENTS


8-14-69

W

26
1962

1/4 Cor. Sec. 18, T31, R22

Found 3/4" I.P. which fits old Tics good,
removed & replaced with C.I. Mon.

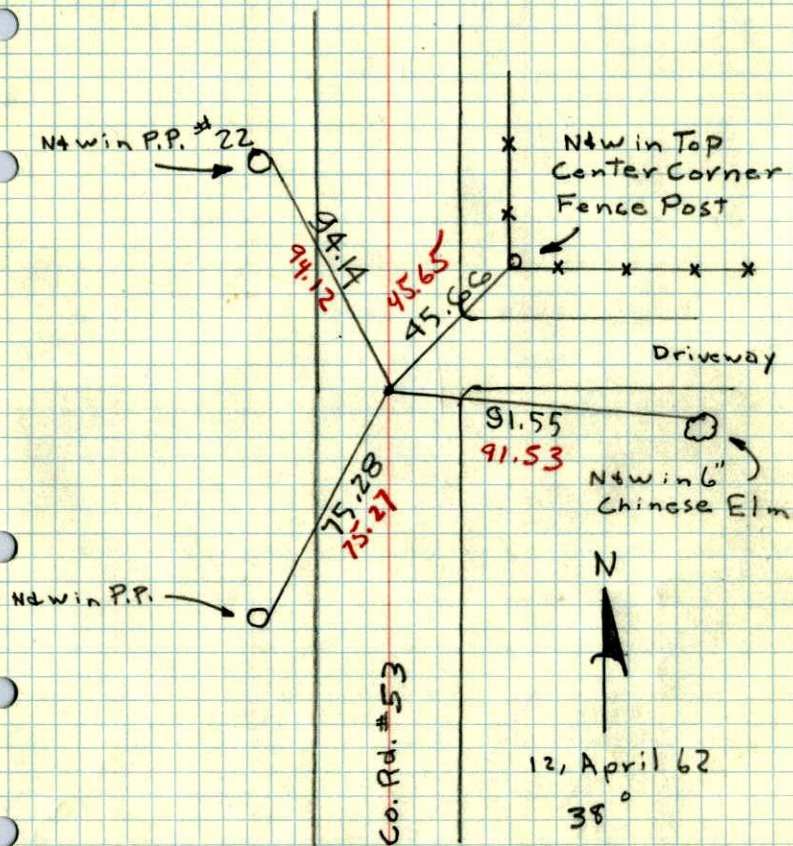

12, April 62


38°

J. Oliver
M. D. Anderson

1958

1/4 SEC. 18, T31, R22

1" IRON 3" DOWN

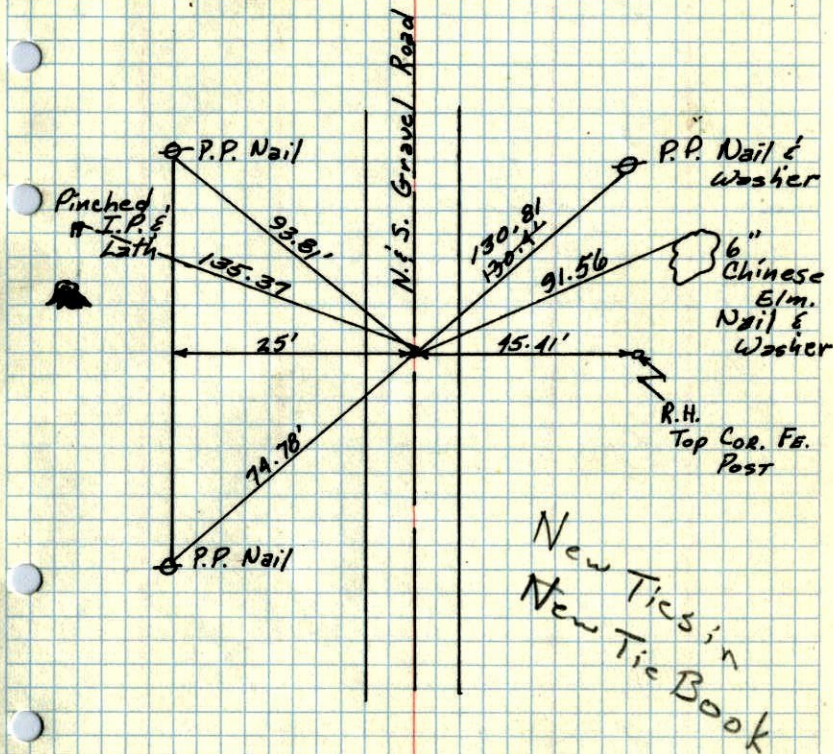

New Tics in
New Tie Book

9/18/59
R.W.H.

G. HOPKINS
Feb. 29, 1958

W 1/4 Cor. Sec. 18-31-22 ¹⁹⁵⁸

Feb. 24, 1958 G. Hopkins

