


N/4 CORNER SECTION 33 T31 R22

FOUND RED AND WHITE IRON PIPE SET

IN OK.

1-5-83
A. LARSON
B. GUETZKO
D. NAGLAK

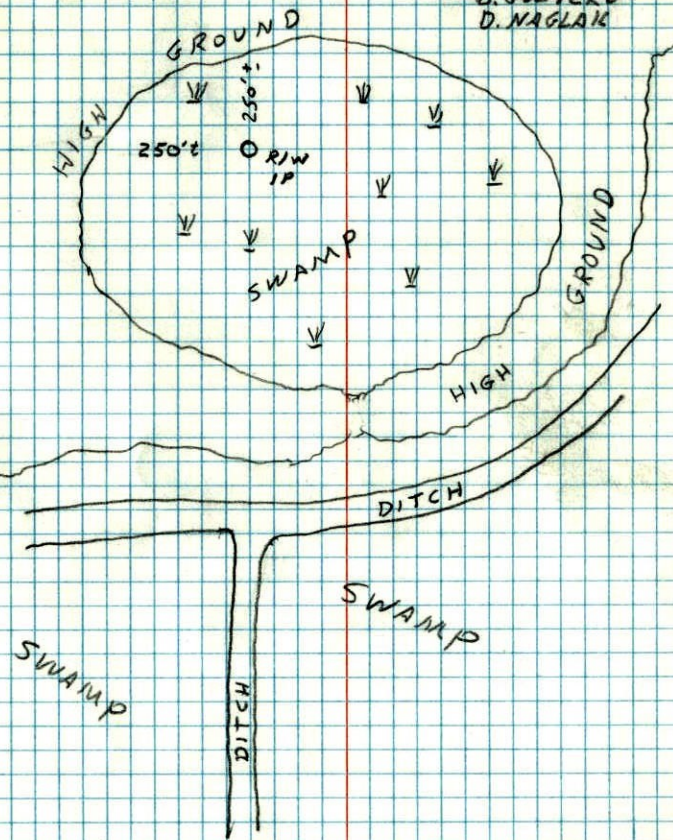

NO. 448

TELETYPE