


N.W. COR OF SEC. 18, T31, R22
 GRANITE Mon.

~~NO DATE~~

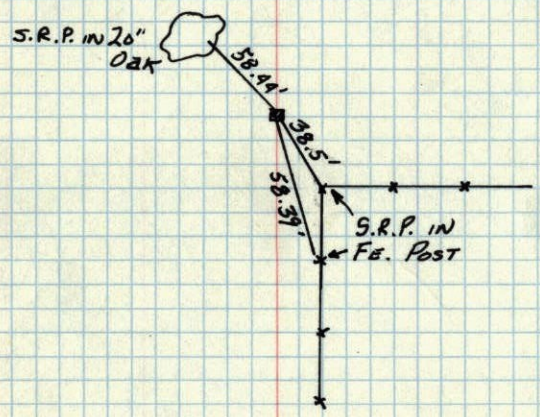

Entered
 as retic
 31 24
 Page 16
 Sec 13.


Retie
 check

M.S.H.D.


N.W. COR. Sec. 18 T31 - R22

~~NO DATE~~

Due

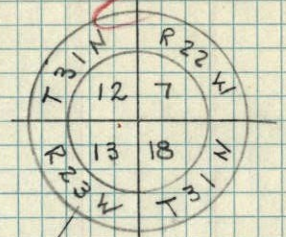

T31 R22

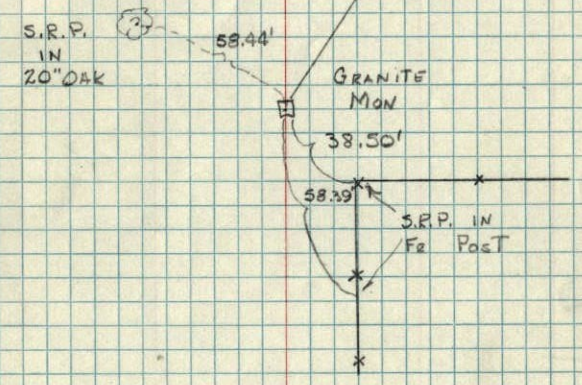

✓