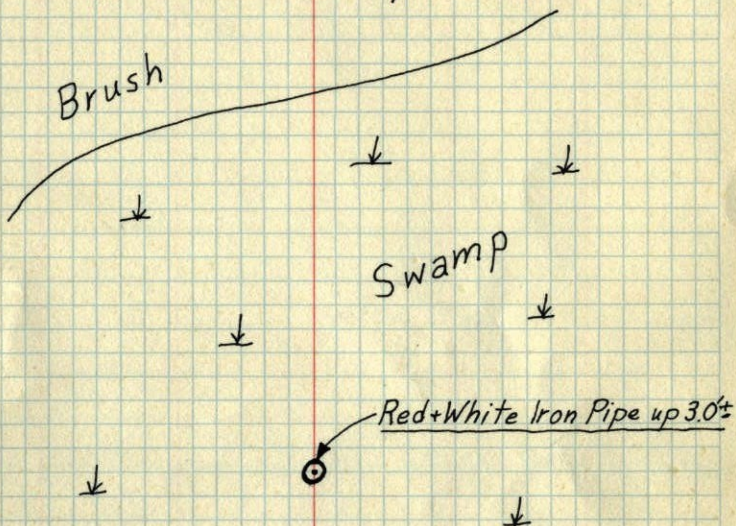


S $\frac{1}{4}$ Cor. Sec. 28-T31-R22Set Red+White Iron Pipe up 3.0'±.Set in place of $\frac{1}{2}$ " Iron Pipe found at
time of area resurvey.

March 14, 1968
M.D. Anderson
H.J. Larson
R.A. Olson

Winter Check.

Checked
1-4-74
H. Larson

Checked
1-4-78
H. Larson
B. Gutzko
J. Boettcher


TEMPERATURE CORRECTED
AND HORIZONTALLY
TAPED MEASUREMENTS

ROLAND W. ANDERSON
COUNTY SURVEYOR
'ANOKA COUNTY, MINNESOTA'

S $\frac{1}{4}$ Cor. Sec. 28-T31-R22

1968

Set Red & White iron pipe up 3.0'±

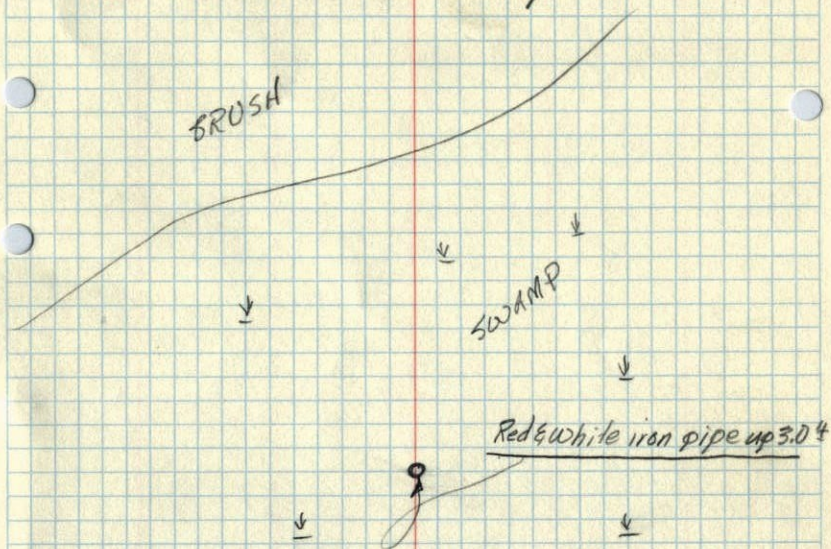set in place of $\frac{1}{2}$ " iron pipe found at
time of area resurvey

March 14, 1968
M.D. Anderson
H.J. Larson
R.A. Olson

TEMPERATURE CORRECTED
AND HORIZONTALLY
TAPED MEASUREMENTS

ROLAND W. ANDERSON
COUNTY SURVEYOR
'ANOKA COUNTY, MINNESOTA'