Const. ties for
W 1/16 cor. S.W. 1/4 Sec 28 T 31-R22

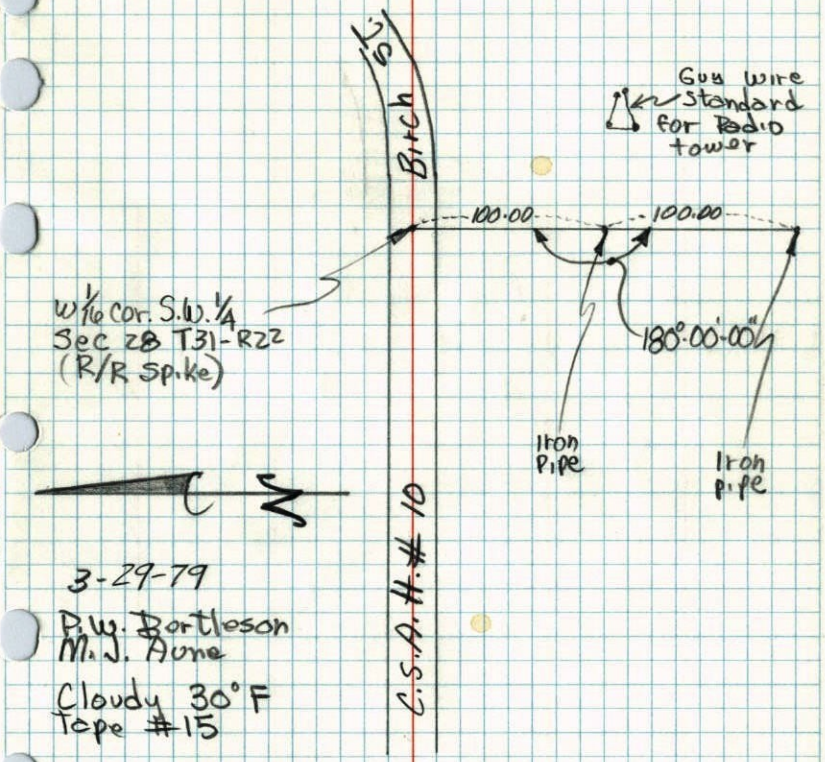


3-29-79

P.W. Bortleson
M.J. Aune

Cloudy 30°F
Tape #15

NO. 448
TELEDYNE