

CERTIFICATE OF LOCATION OF GOVERNMENT CORNER

County of Anoka

State of Minnesota


North $\frac{1}{4}$ Corner of Sec. 1 Township 31 Range 22


On the 10th day of July, 1974, the described corner was evidenced by area resurvey

and to perpetuate the location of said corner, at the exact location thereof, a permanent marker was placed consisting of a red and white iron pipe

AND on the 28th day of December, 2010, said permanent marker was found broken off 0.2'± above the ice and the ties were updated

Updated reference ties are as shown below.

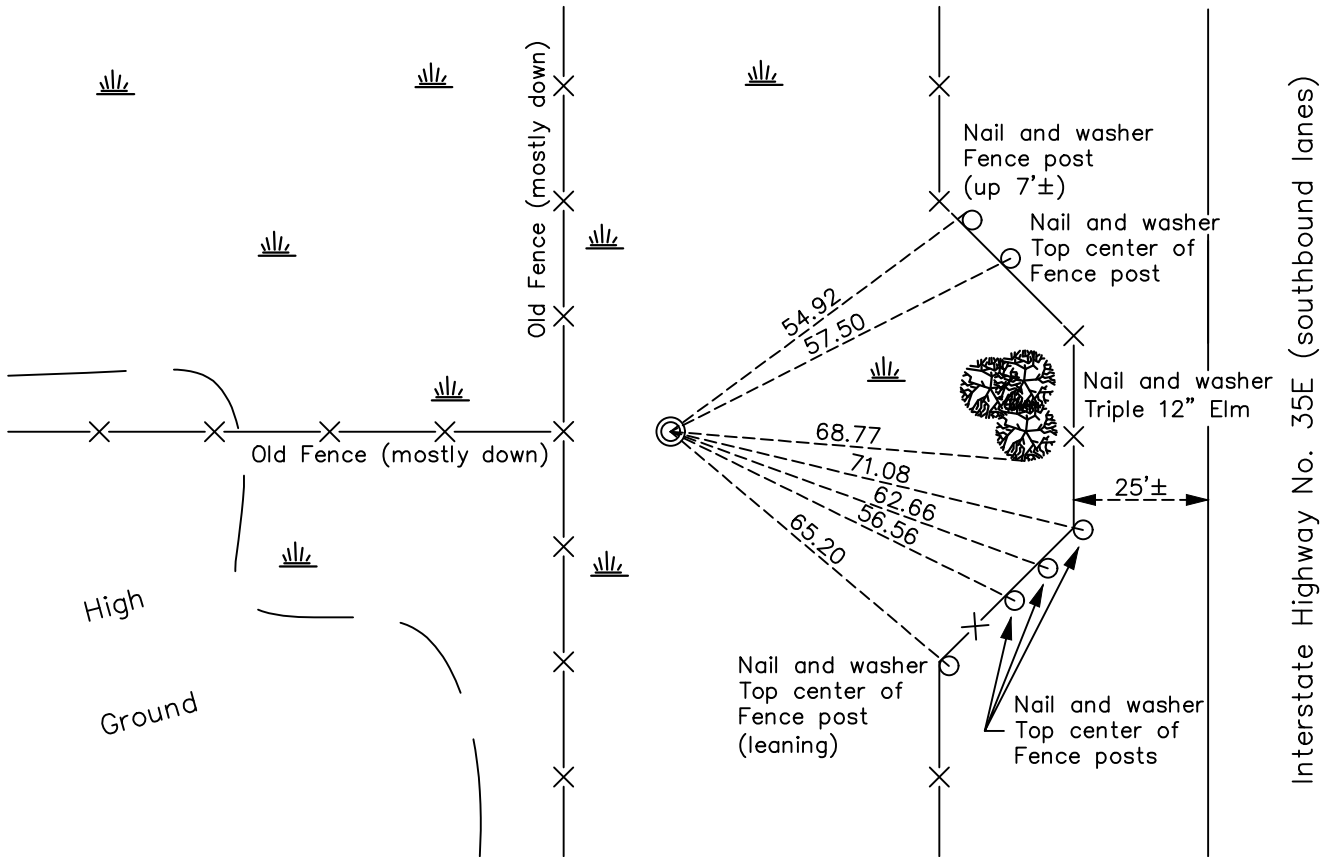

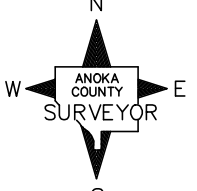N

 W ANOKA COUNTY SURVEYOR E
 S

Revision Date
3/03/11

N.A.D. 1983 Coordinates
(1996 Adjustment)

County Project Coordinates	
Northing	<u>164121.2685</u>
Easting	<u>561017.6799</u>
Date	<u>2/25/98</u>

I hereby certify that this United States public land survey monument record is correct and complete to the best of my knowledge and belief.

David M. Zieglmeier Date 8/27/21

David M. Zieglmeier, Anoka County Surveyor
 Minnesota License Number 46179

HISTORY OF GOVERNMENT CORNER

County of Anoka

State of Minnesota

North 1/4 Corner of Sec. 1 Township 31 Range 22

CORNER HISTORY:

July 10, 1974 – Found red and white Iron Pipe. Established ties to monument.

August 10, 1979 – Found Iron Pipe. Updated ties.

July 13, 1982 – Found Iron Pipe. Updated ties.

August 6, 1985 – Found Iron Pipe. Updated ties.

May 8, 1989 – Found Iron Pipe. Updated ties.

July 10, 1996 – Found Iron Pipe. Updated ties.

February 25, 1998 – Found Iron Pipe. Updated ties. Established NAD 1983 (1996 Adjustment) Anoka County Project coordinates by Static GPS methods.

December 28, 2010 – Found Iron Pipe broken off 0.2'± above ice. Updated ties.

March 8, 2011 – Verified position using Static GPS methods.