

# CERTIFICATE OF LOCATION OF GOVERNMENT CORNER

County of Anoka

State of Minnesota



## West 1/4 Corner of Sec. 10 Township 31 Range 22

On the 25th day of February, 1964, the described corner was evidenced by a 3/4" axle shaft from the plat of "Lake View Woodlands"

and to perpetuate the location of said corner, at the exact location thereof, a permanent marker was placed consisting of a red and white iron pipe

AND on the 3rd day of June, 2021, said permanent marker was a red and white 2" square steel Telespar monument up 4'± with a sign attached and the ties were updated

Updated reference ties are as shown below.

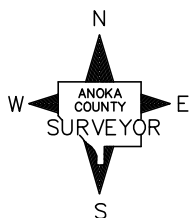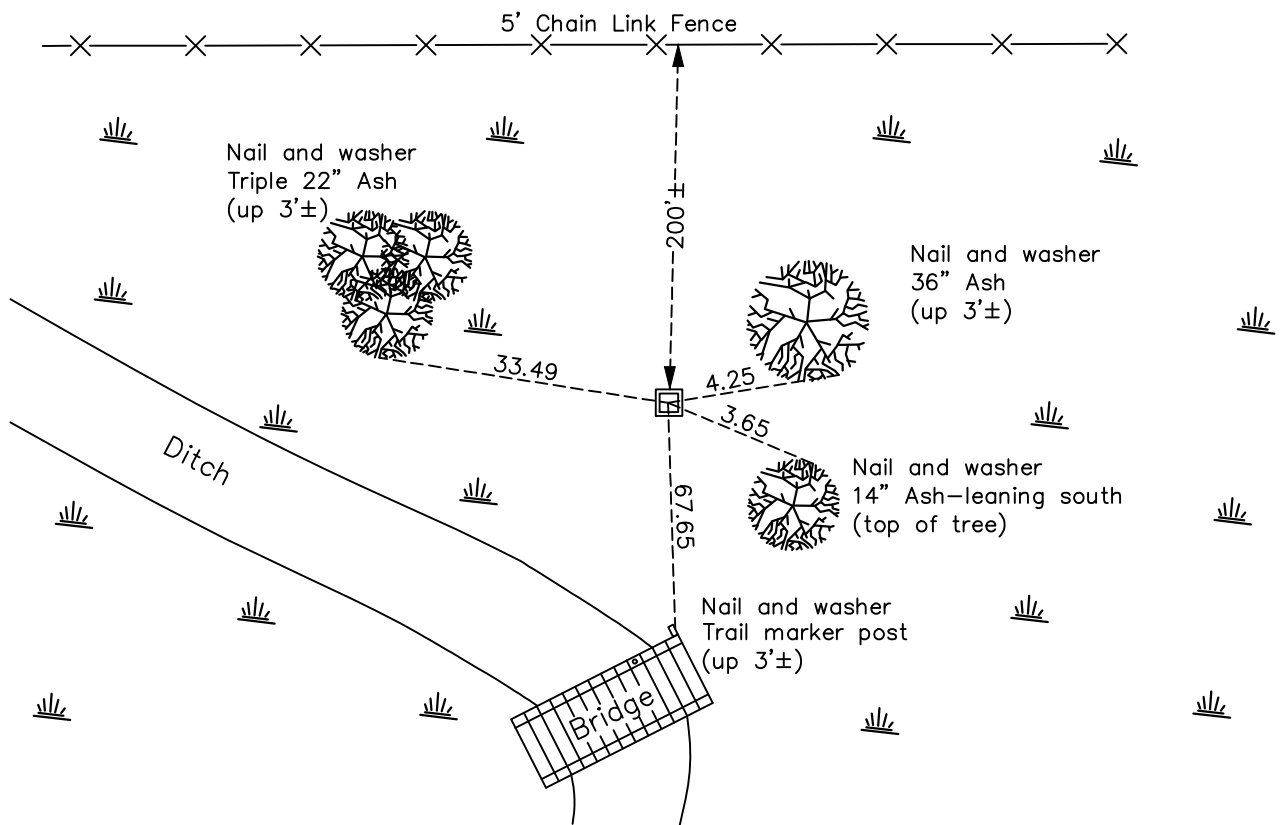

Revision Date  
 7/26/21

N.A.D. 1983 Coordinates  
 (1996 Adjustment)

| County Project Coordinates |             |
|----------------------------|-------------|
| Northing                   | 156194.9530 |
| Easting                    | 547717.8876 |
| Date                       | 2/09/98     |

I hereby certify that this United States public land survey monument record is correct and complete to the best of my knowledge and belief.

*David M Zieglsmeier* Date 8/30/21

David M. Zieglsmeier, Anoka County Surveyor  
 Minnesota License Number 46179

# HISTORY OF GOVERNMENT CORNER

Page No. 39

County of Anoka

State of Minnesota

## West 1/4 Corner of Sec. 10 Township 31 Range 22

### **CORNER HISTORY:**

February 25, 1964 – Found 3/4” Axle Shaft from the plat of ”Lake View Woodlands”. Replaced Axle shaft with 1”X10’ Red and White Iron Pipe. Established ties to monument.

March 28, 1966 – Set sign and post.

August 15, 1969 – Could not find Red and White Iron Pipe.

January 15, 1974 – Found Red and White Iron Pipe up 1’± and leaning west with a sign and post up 8’±. Updated ties.

January 4, 1978 – Found Red and White Iron Pipe and updated ties.

August 21, 1979 – Reset Red and White Iron Pipe from plat of ”Lake View Woodlands” up 3’± with sign. Updated ties.

June 8, 1980 – Found Red and White Iron Pipe and updated ties.

July 24, 1986 – Found Red and White Iron Pipe and updated ties.

December 6, 1996 – Found Red and White Iron Pipe and updated ties.

February 9, 1998 – Found Red and White Iron Pipe and established NAD 1983 (1996 Adjustment) Anoka County Project Coordinates by Static GPS methods. Updated ties.

August 18, 2010 – Found Red and White Iron Pipe up 3’± with a sign attached and updated ties.

January 27, 2017 – Found Red and White 2” square steel Telespar monument up 4’± with a sign attached and updated ties.

June 3, 2021 – Found Red and White 2” square steel Telespar monument up 4’± with a sign attached and updated ties.