

CERTIFICATE OF LOCATION OF GOVERNMENT CORNER

County of Anoka

State of Minnesota



Center Corner of Sec. 14 Township 31 Range 22

On the 9th day of July, 1965, the described corner was evidenced by a 1/2" iron pipe

and to perpetuate the location of said corner, at the exact location thereof, a permanent marker was placed consisting of a 1/2" iron pipe

AND on the 22nd day of June, 2022, said permanent marker was found down 0.4'± under blacktop road. Verified position by VRS GPS methods and updated ties.

Updated reference ties are as shown below.

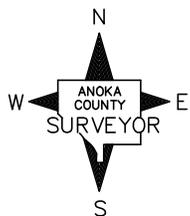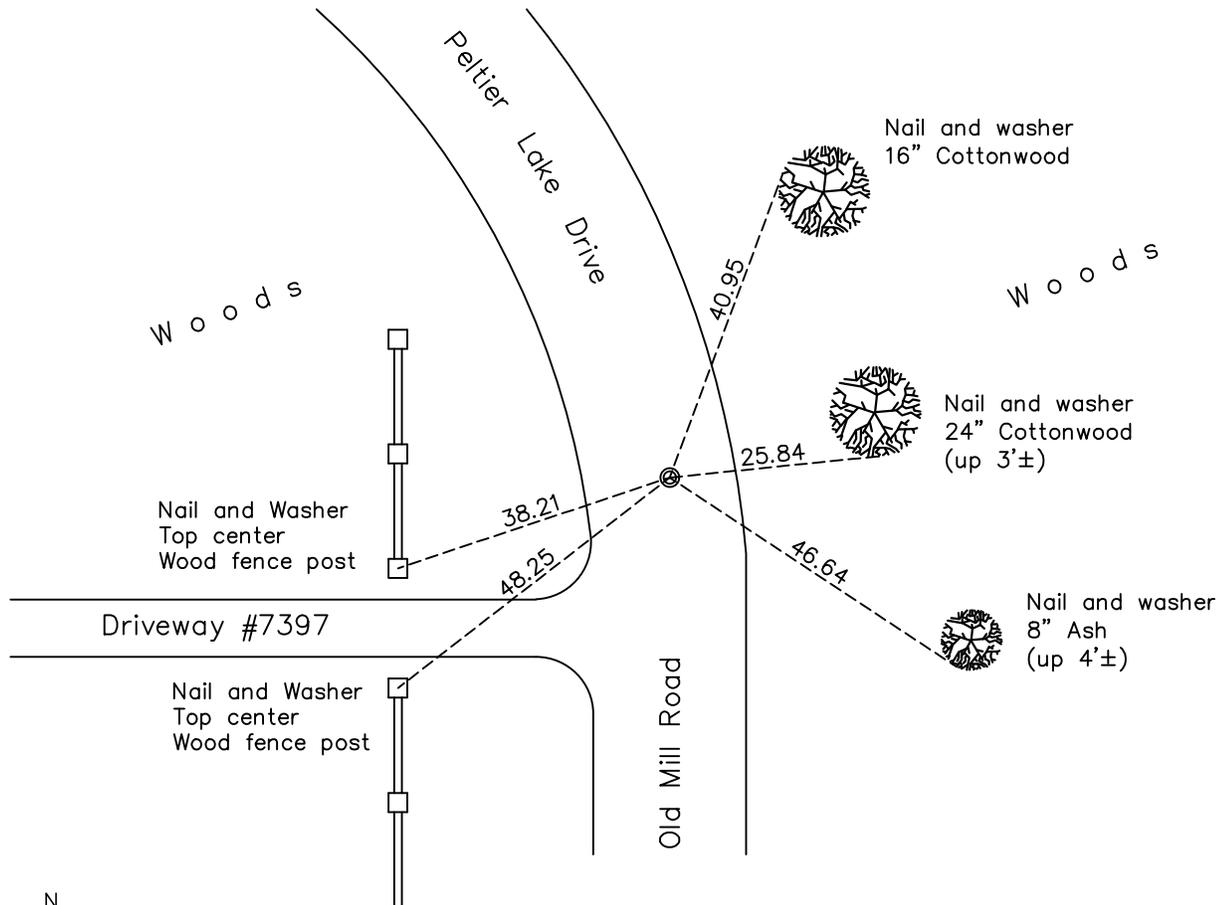

Revision Date
7/1/2022

N.A.D. 1983 Coordinates
(1996 Adjustment)

County Project Coordinates	
Northing	<u>150956.4643</u>
Easting	<u>555599.2221</u>
Date	<u>4/05/2021</u>

I hereby certify that this United States public land survey monument record is correct and complete to the best of my knowledge and belief.

David Zieglmeier Date 6/28/23

David M. Zieglmeier, Anoka County Surveyor
Minnesota License Number 46179

HISTORY OF GOVERNMENT CORNER

Page No. 64

County of Anoka

State of Minnesota

Center Corner of Sec. 14 Township 31 Range 22

CORNER HISTORY:

1963 - C.O. Georgi found an iron pipe and updated the ties.

July 9, 1965 - Found 1/2" iron pipe down 0.3'± using 1963 ties by C.O. Georgi. Updated ties.

August 5, 1969 - Found 1/2" iron pipe bent and replaced with a new iron pipe down 1.3'±. Updated ties.

June 18, 1973 - Found 1/2" iron pipe and updated ties.

August 18, 1976 - Found 1/2" iron pipe and updated ties.

July 29, 1980 - Found 1/2" iron pipe and updated ties.

November 5, 1990 - Found 1/2" iron pipe and updated ties.

October 28, 1991 - Found 1/2" iron pipe and updated ties.

April 5, 2021 - Found 1/2" iron pipe down 0.4'± under blacktop road. Established NAD 1983 (1996 adj.) Anoka County project coordinates by static GPS methods.

July 1, 2022 - Found 1/2" iron pipe down 0.4'± under blacktop road. Verified position by VRS GPS methods. Updated ties.