

CERTIFICATE OF LOCATION OF GOVERNMENT CORNER

County of Anoka

State of Minnesota


Witness Corner of Sec. 21 Township 31 Range 22
(on north line of section east of George Watch Lake)

On the 29th day of March, 1968, the described corner was evidenced by area resurvey

and to perpetuate the location of said corner, at the exact location thereof, a permanent marker was placed consisting of a cast iron monument with a sign and post on the north side

AND on the 10th day of March, 2023, said permanent marker was removed and replaced with new steel Telspar, set up 18" with cap & punchmark using County RTK GPS method, then updated ties.

Updated reference ties are as shown below.

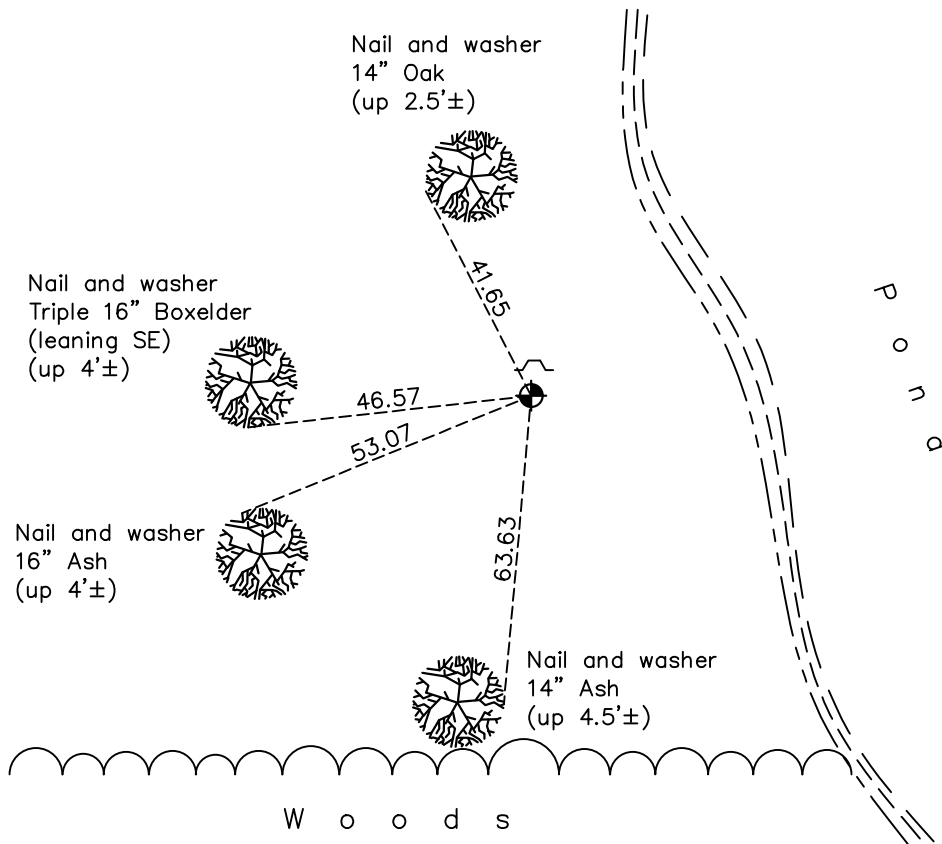

Revision Date
3/27/2023

N.A.D. 1983 Coordinates (1996 Adjustment)	
County Project Coordinates	
Northing	<u>148285.3262</u>
Easting	<u>546958.5672</u>
Date	<u>2/23/98</u>

I hereby certify that this United States public land survey monument record is correct and complete to the best of my knowledge and belief.
David Zieglmeier Date 12/11/23
 David Zieglmeier Anoka County Surveyor
 Minnesota License Number 46179

HISTORY OF GOVERNMENT CORNER

Page No. 75

County of Anoka

State of Minnesota

Witness Corner of Sec. 21 Township 31 Range 22
(on north line of section east of George Watch Lake)

CORNER HISTORY:

March 29, 1968 – Set Cast Iron Monument flush with the surface on the east side of George Watch Lake using area resurvey. Established ties to monument.

July 19, 1973 – Found Cast Iron Monument and updated ties.

May 19, 1977– Found Cast Iron Monument and updated ties.

July 29, 1986 – Found Cast Iron Monument and updated ties.

October 5, 1989 – Found Cast Iron Monument and updated ties.

October 14, 1991 – Found Cast Iron Monument with sign and post on the north side. Updated ties.

July 25, 1996 – Found Cast Iron Monument and updated ties.

February 23, 1998 – Found Cast Iron Monument down 0.2'± and established NAD 1983 (1996 Adjustment) Anoka County Project Coordinates by Static GPS methods. Updated ties.

September 2, 2010 – Found Cast Iron Monument down 0.2'± and updated ties.

January 26, 2017 – Found Cast Iron Monument down 0.2'± and updated ties.

April 20, 2021 – Found Cast Iron Monument down 0.2'±, Verified location of corner by VRS GPS methods and updated ties.

March 10, 2023 – Removed leaning Cast Iron Monument and replaced with new steel Telspar, set up 18" with 'county surveyor' cap and punch mark using County RTK GPS method. Updated and verified historical ties after replacement.