

CERTIFICATE OF LOCATION OF GOVERNMENT CORNER

County of Anoka

State of Minnesota

Center Corner of Sec. 31 Township 31 Range 22


I hereby certify that on the 4th day of September, 1968, I found the described corner which was evidenced by ties by C. O. Georgi 6/28/23 J. SIMMER, D. DURDAHL

and I further certify that to perpetuate the location of said corner, I did, at the exact location thereof, place a permanent marker consisting of a 2 1/2" iron pipe

which reference or witness monuments are located in the manner following:


19 1/3/2021 JS

5/4/23 - Ties pulled to position. Avoid 10' to 11' North of computed. Faint Ping; but sounds laying down, & not at Apex of Ties pulled.

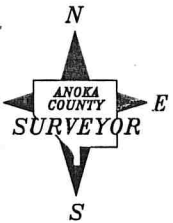

MON. IS GONE + NEW DEVELOPMENT
FD (2) TIES + TAPED IN. (NO BEEP)

Computed
N = 135058.757
E = 534655.372

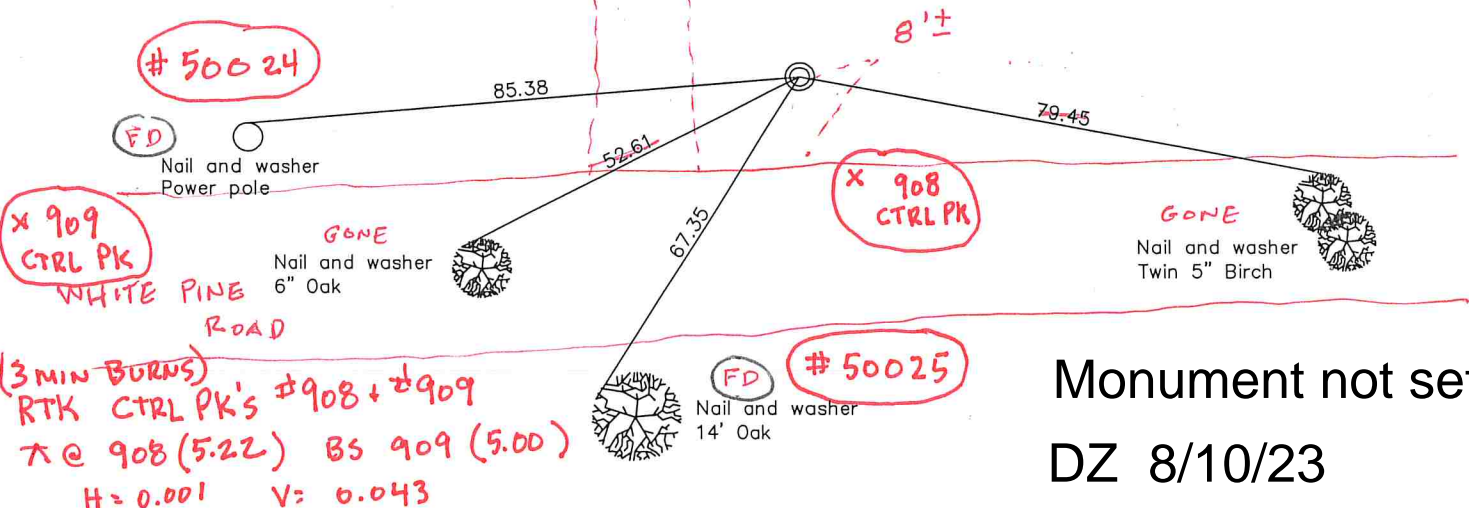

Monument not set
DZ 8/10/23

ACCEPTED + SHOT SWING TIES

SHOT 2 SWING TIES USING TRIMBLE TOTAL + MINI PRISM

Revised date

N.A.D. 1983 Co-ordinates

11/5/90

County Project Co-ordinates
Northing _____
Easting _____

State Plane Co-ordinates
Y _____
X _____

Date _____