

CERTIFICATE OF LOCATION OF GOVERNMENT CORNER

County of Anoka

State of Minnesota



Center Corner of Sec. 36 Township 31 Range 22

I hereby certify that on the ___ day of _____, ___, I found the described corner which was evidenced by _____ (FOR REFERENCE ONLY)

and I further certify that to perpetuate the location of said corner, I did, at the exact location thereof, place a permanent marker consisting of _____

which reference or witness monuments are located in the manner following:

1-19-2021 JS
UNABLE TO LOCATE
OR FIND TIES

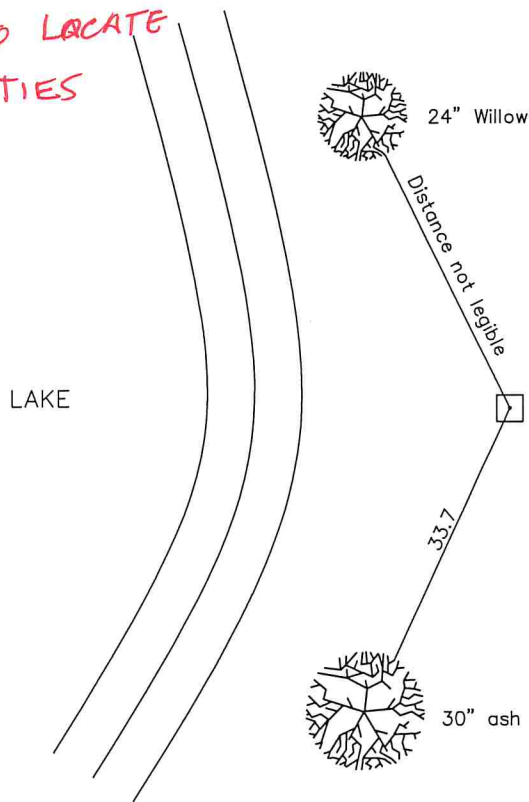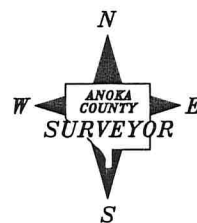

Computed
N=135037.51
E=560935.42

Revised date

Table with 4 empty rows for revised date.

N.A.D. 1983 Co-ordinates

Table with 2 columns: County Project Co-ordinates (Northing, Easting) and State Plane Co-ordinates (Y, X).

Date _____