

# CERTIFICATE OF LOCATION OF GOVERNMENT CORNER

County of Anoka

State of Minnesota


## Northeast Corner of Sec. 1 Township 33 Range 22

On the 12th day of April, 1962, the described corner was evidenced by a 8" square granite monument

and to perpetuate the location of said corner, at the exact location thereof, a permanent marker was placed consisting of the same granite monument ('33-22-S1' is etched on top)

AND on the 18th day of February, 2022, said permanent marker was found up 0.6'± and leaning northeasterly. The ties were updated.

Updated reference ties are as shown below.

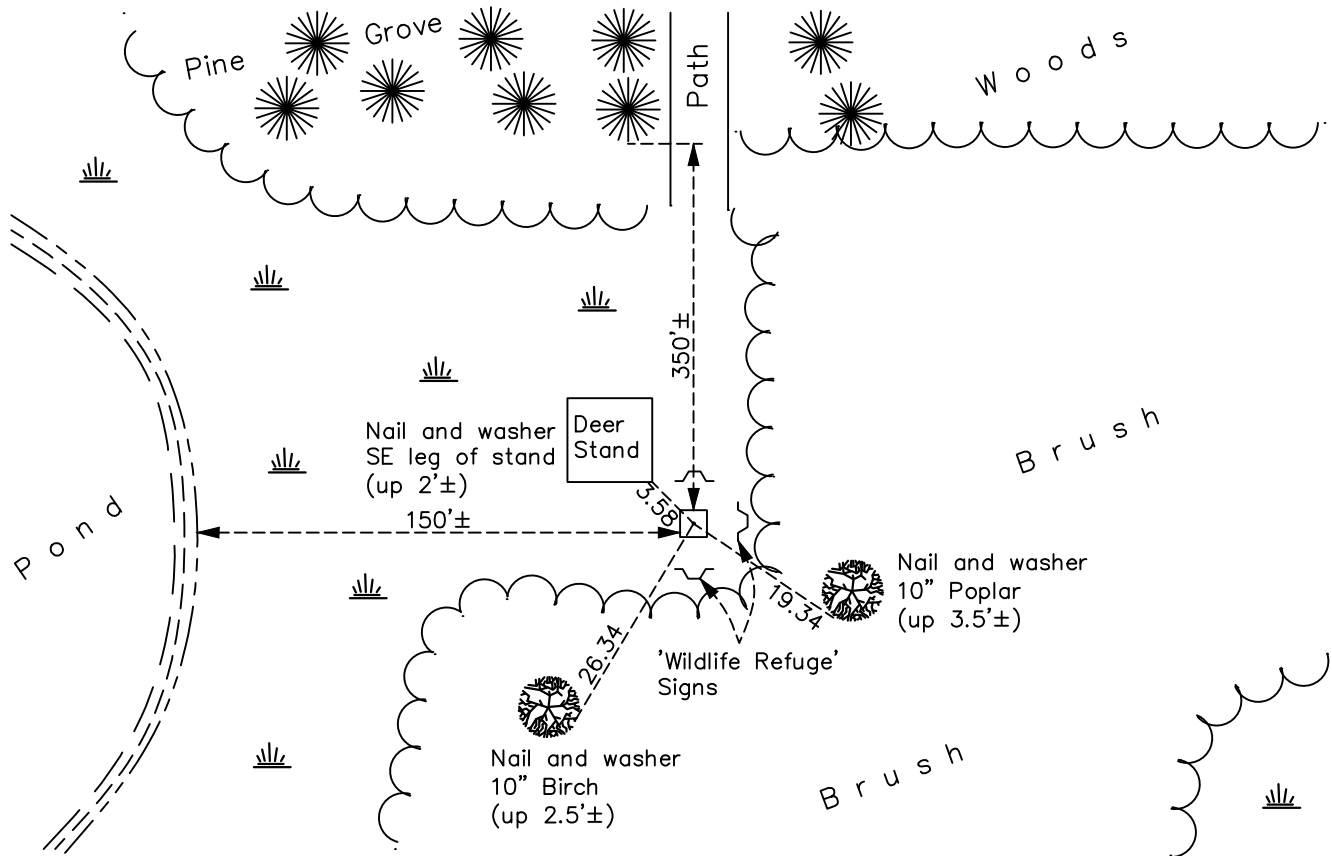

Revision Date  
03/16/22

N.A.D. 1983 Coordinates  
 (1996 Adjustment)

County Project Coordinates	
Northing	<u>226769.6950</u>
Easting	<u>563765.7250</u>
Date	<u>4/08/04</u>

I hereby certify that this United States public land survey monument record is correct and complete to the best of my knowledge and belief.

*David Zieglsmeier* Date 6/28/23

David M. Zieglsmeier, Anoka County Surveyor  
 Minnesota License Number 46179

# HISTORY OF GOVERNMENT CORNER

Page No. 1

County of Anoka

State of Minnesota

## Northeast Corner of Sec. 1 Township 33 Range 22

### **CORNER HISTORY:**

April 12, 1962 - Found 8" square granite up 0.5' inscribed with T33 R22 S1. Established ties to monument.

June 20, 1967 - Found granite monument and updated ties.

July 14, 1971 - Found granite monument and updated ties.

July 21, 1975 - Found granite monument and updated ties.

July 18, 1978 - Found granite monument and updated ties.

August 19, 1981 - Found granite monument and updated ties.

November 2, 1990 - Found granite monument and updated ties.

June 14, 1993 - Found granite monument and updated ties.

July 10, 2003 - Found granite monument and updated ties.

April 8, 2004 - Established NAD 1983 (1996 adj.) Anoka County project coordinates by static GPS methods.

February 18, 2014 - Found granite monument up 0.6'± leaning northeasterly, verified position by VRS GPS methods and updated ties.

February 18, 2022 - Found granite monument up 0.6'± leaning northeasterly, verified position by VRS GPS methods and updated ties.