

CERTIFICATE OF LOCATION OF GOVERNMENT CORNER

County of Anoka

State of Minnesota


North 1/4 Corner of Sec. 5 Township 33 Range 22

On the 4th day of March, 1973, the described corner was evidenced by area resurvey

and to perpetuate the location of said corner, at the exact location thereof, a permanent marker was placed consisting of a red and white iron pipe

AND on the 29th day of March, 2022, said permanent marker was found up 3'± & leaning NW'ly. All ties were gone with no features to tie to. Position was verified using VRS GPS methods.

Updated reference ties are as shown below.

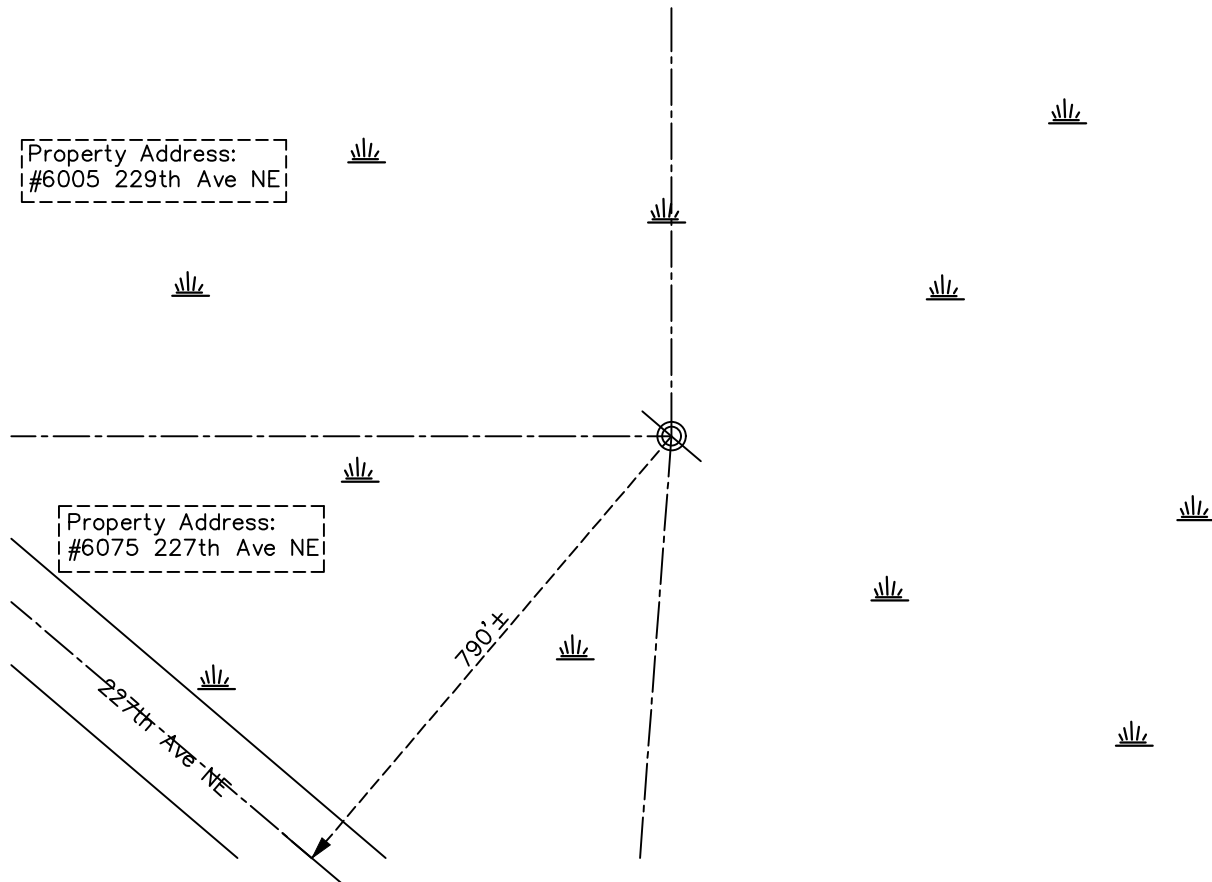

N
W ANOKA COUNTY SURVEYOR E
S

Revision Date
4/07/2022

N.A.D. 1983 Coordinates
(1996 Adjustment)

County Project Coordinates	
Northing	227467.1323
Easting	540104.1508
Date	4/19/04

I hereby certify that this United States public land survey monument record is correct and complete to the best of my knowledge and belief.

David Zieglmeier Date 12/11/23

David Zieglmeier Anoka County Surveyor
Minnesota License Number 46179

HISTORY OF GOVERNMENT CORNER

Page No. 10

County of Anoka

State of Minnesota

North 1/4 Corner of Sec. 5 Township 33 Range 22

CORNER HISTORY:

March 4, 1973 - Found red and white iron pipe using area resurvey and established ties to monument.

April 19, 2004 - Established NAD 1983 (1996 adj.) Anoka County Project coordinates by static GPS methods.

December 31, 2013 - Found red and white iron pipe up 3'± leaning northwesterly. All ties were gone. Verified position by VRS GPS methods.

March 29, 2022 - Found red and white iron pipe up 3'± leaning northwesterly and verified position by VRS GPS method. No ties available.