

CERTIFICATE OF LOCATION OF GOVERNMENT CORNER

County of Anoka

State of Minnesota


Witness Corner of Sec. 4 Township 33 Range 22
(on east line of SE 1/4)

On the 12th day of August, 1974, the described corner was evidenced by area resurvey

and to perpetuate the location of said corner, at the exact location thereof, a permanent marker was placed consisting of a cast iron monument with a sign and post on the north side

AND on the 23rd day of March, 2022, said permanent marker was found flush and the ties were updated

Updated reference ties are as shown below.

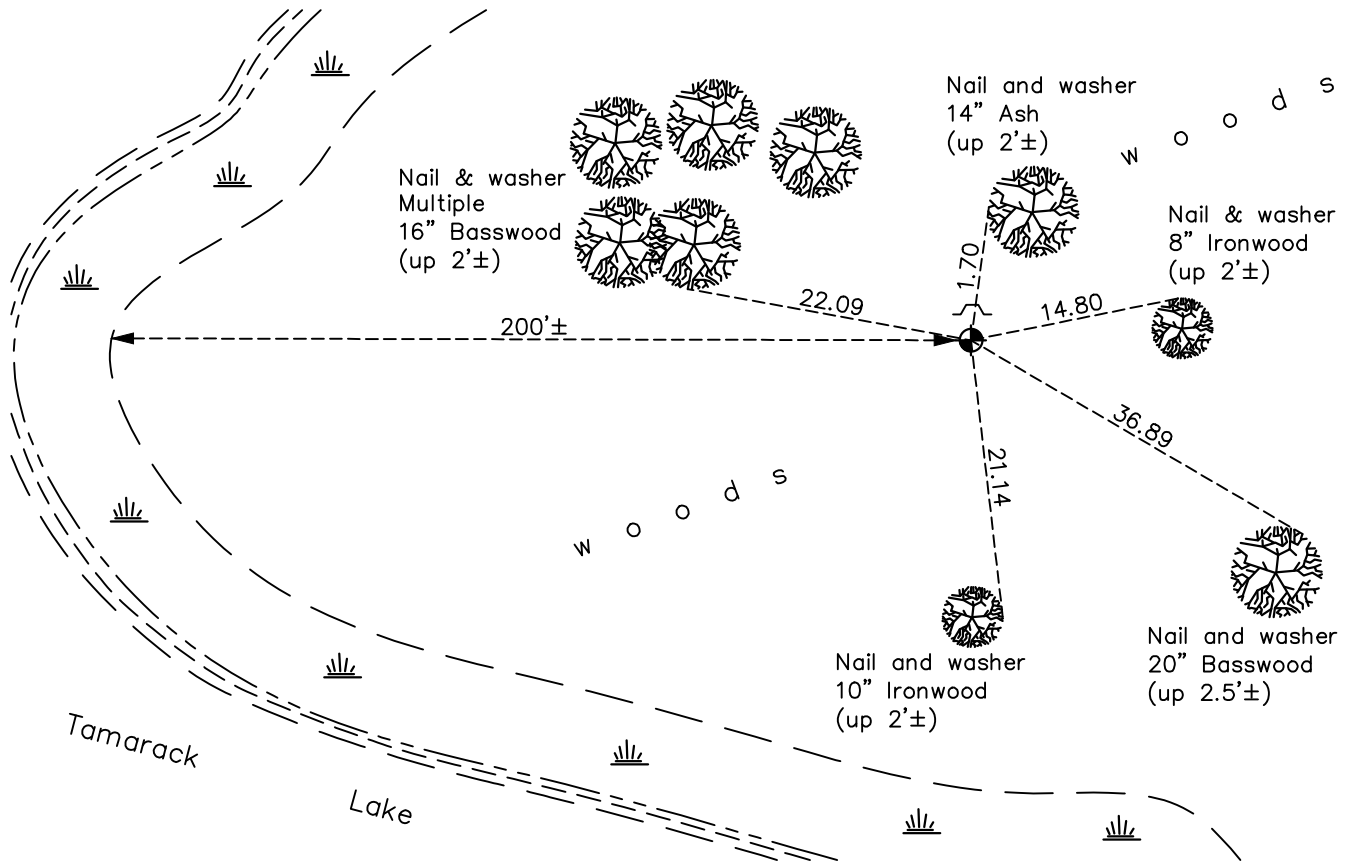

Revision Date
4/08/2022

N.A.D. 1983 Coordinates
(1996 Adjustment)

County Project Coordinates	
Northing	<u>223532.4343</u>
Easting	<u>547984.0897</u>
Date	<u>1/31/05</u>

I hereby certify that this United States public land survey monument record is correct and complete to the best of my knowledge and belief.

David Zieglmeier Date 12/11/23

David Zieglmeier Anoka County Surveyor
 Minnesota License Number 46179

HISTORY OF GOVERNMENT CORNER

Page No. 18

County of Anoka

State of Minnesota

Witness Corner of Sec. 4 Township 33 Range 22
(on east line of SE 1/4)

CORNER HISTORY:

August 12, 1974 - Set cast iron monument flush using area resurvey. Established ties to monument.

July 22, 1975 - Found cast iron monument and updated ties.

July 19, 1978 - Found cast iron monument and updated ties.

December 26, 1990 - Found cast iron monument and updated ties.

June 30, 1993 - Found cast iron monument and updated ties.

April 1, 2004 - Found cast iron monument and updated ties.

January 31, 2005 - Established NAD 1983 (1996 adj.) Anoka County project coordinates by static GPS methods.

November 26, 2013 - Found cast iron monument and updated ties.

April 19, 2019 - Found cast iron monument flush and updated ties.

March 23, 2022 - Found cast iron monument flush and verified position by GPS VRS method. Updated ties.