

# CERTIFICATE OF LOCATION OF GOVERNMENT CORNER

County of Anoka

State of Minnesota


## Northeast Corner of Sec. 10 Township 33 Range 22

On the 10th day of July, 1974, the described corner was evidenced by area resurvey

and to perpetuate the location of said corner, at the exact location thereof, a permanent marker was placed consisting of a cast iron monument with a sign and post on the north side

AND on the 18th day of February, 2022, said permanent marker was found up 0.2± and the ties were updated

Updated reference ties are as shown below.

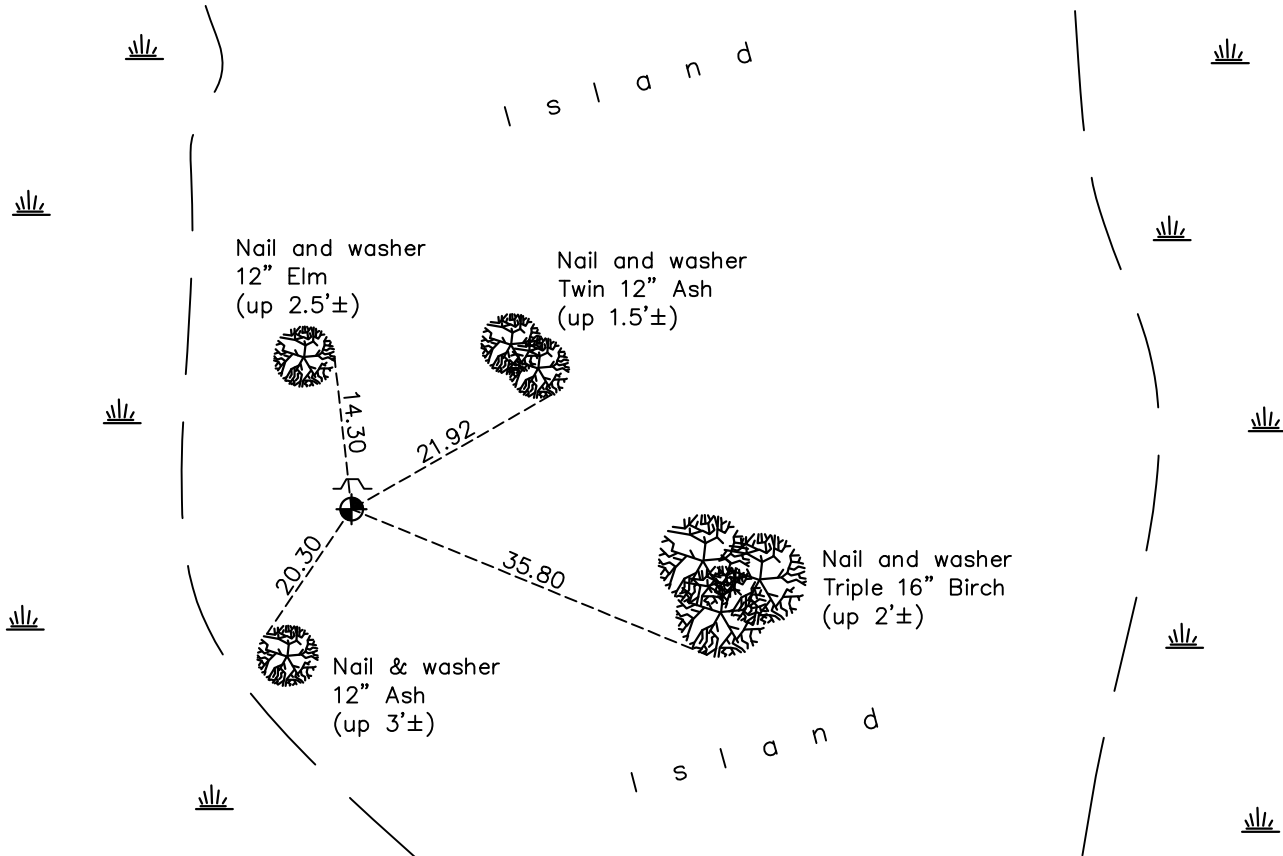

Revision Date

03/16/22

N.A.D. 1983 Coordinates  
(1996 Adjustment)

County Project Coordinates	
Northing	<u>222079.9607</u>
Easting	<u>553208.9218</u>
Date	<u>2/23/05</u>

I hereby certify that this United States public land survey monument record is correct and complete to the best of my knowledge and belief.

*David Zieglmeier* Date 12/11/23

David M. Zieglmeier, Anoka County Surveyor  
Minnesota License Number 46179

# HISTORY OF GOVERNMENT CORNER

Page No. 26

County of Anoka

State of Minnesota

## Northeast Corner of Sec. 10 Township 33 Range 22

### **CORNER HISTORY:**

July 10, 1974 - Set cast iron monument using area resurvey.

May 23, 1990 - Found cast iron monument and updated ties. Placed sign and post on north side.

June 8, 1995 - Found cast iron monument and updated ties.

February 23, 2005 - Established NAD 1983 (1996 adj.) Anoka County project coordinates by static GPS methods.

December 10, 2013 - Found cast iron monument and updated ties.

February 18, 2022 - Found cast iron monument up  $0.2' \pm$ . Verified position by VRS GPS methods. Updated ties.