

# CERTIFICATE OF LOCATION OF GOVERNMENT CORNER

County of Anoka

State of Minnesota


## Northeast Corner of Sec. 8 Township 33 Range 22

On the 18th day of January, 1965, the described corner was evidenced by area resurvey

and to perpetuate the location of said corner, at the exact location thereof, a permanent marker was placed consisting of a 2" square telspar up 1'±

AND on the 28th day of February, 2022, said permanent marker was found 2" square steel Telespar monument up 1'± with punch mark in "Surveyors Cap" and sign & post on north side

Updated reference ties are as shown below.

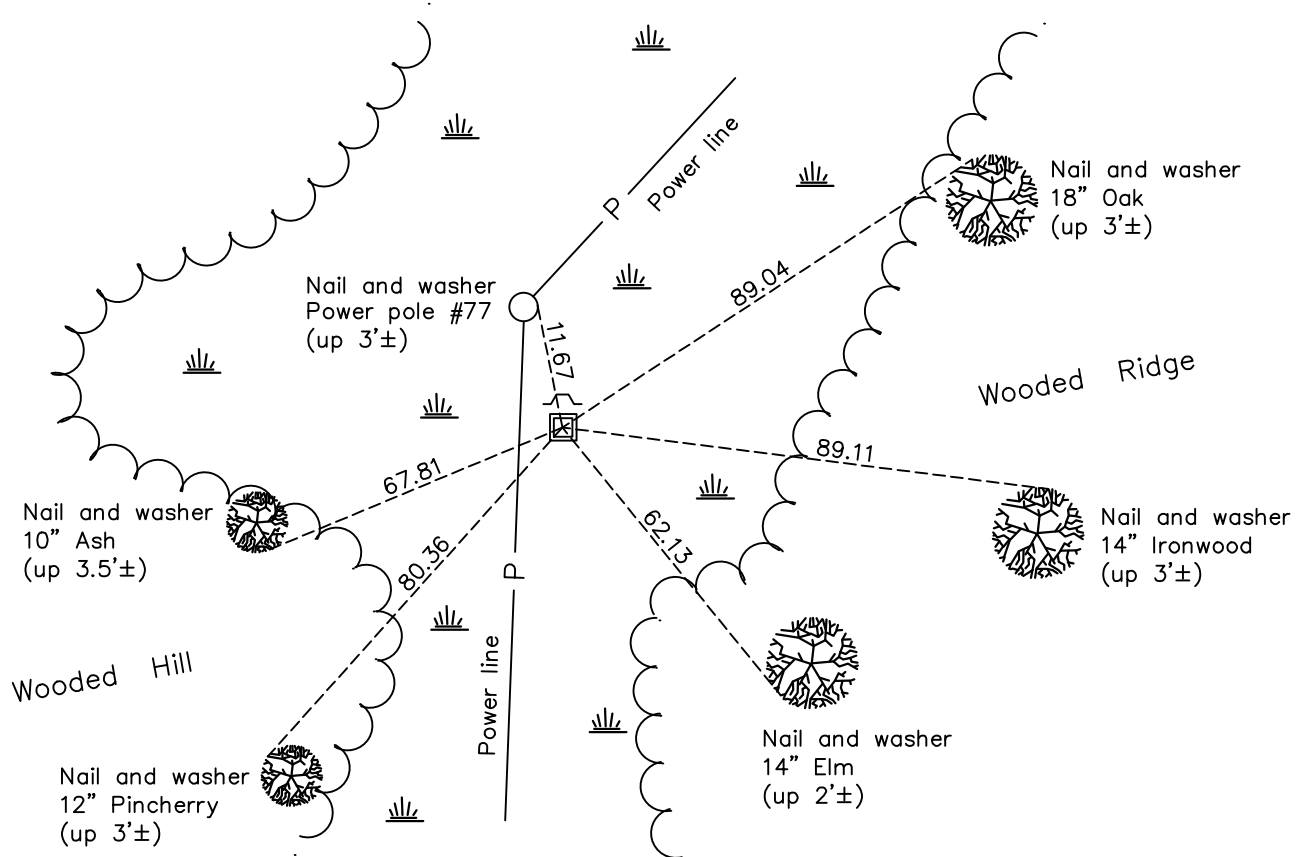

Revision Date

03/17/22

N.A.D. 1983 Coordinates  
(1996 Adjustment)

County Project Coordinates	
Northing	<u>222204.7673</u>
Easting	<u>542486.5974</u>
Date	<u>4/12/04</u>

I hereby certify that this United States public land survey monument record is correct and complete to the best of my knowledge and belief.

*David Zieglermeier* Date 12/11/23

David M. Zieglermeier, Anoka County Surveyor  
Minnesota License Number 46179

# HISTORY OF GOVERNMENT CORNER

Page No. 31

County of Anoka

State of Minnesota

## Northeast Corner of Sec. 8 Township 33 Range 22

### **CORNER HISTORY:**

January 18, 1965 - Set 1" x 8' red and white iron pipe using area resurvey. Established ties to iron pipe.

July 11, 1967 - Found red and white iron pipe and updated ties.

July 15, 1971 - Found red and white iron pipe and updated ties.

July 22, 1975 - Found red and white iron pipe and updated ties.

April 16, 1980 - Found red and white iron pipe and updated ties prior to power line construction.

June 19, 1985 - Found red and white iron pipe up 3'± and updated ties.

August 26, 1987 - Found red and white iron pipe and updated ties.

July 17, 1995 - Found red and white iron pipe and updated ties.

July 10, 2003 - Found red and white iron pipe and updated ties.

April 12, 2004 - Established NAD 1983 (1996 adj.) Anoka County project coordinates by static GPS methods.

December 9, 2013 - Found red and white iron pipe and updated ties.

February 26, 2016 - Found red and white iron pipe and replaced with a 8' square steel telspar up 1'± with a punchmarked cap. Placed a sign and post on the north side. Updated ties.

February 28, 2022 - Found 2" square steel telspar up 1'± with a punchmarked cap. Placed a sign and post on the north side. Verified position by VRS GPS methods. Updated ties.