

CERTIFICATE OF LOCATION OF GOVERNMENT CORNER

County of Anoka

State of Minnesota



Northwest Corner of Sec. 8 Township 33 Range 22

On the 10th day of December, 1946, the described corner was evidenced by a 1 1/2" iron pipe

and to perpetuate the location of said corner, at the exact location thereof, a permanent marker was placed consisting of a cast iron monument with a sign and post on the north side

AND on the 14th day of December, 2021, said permanent marker was found flush and the ties were updated

Updated reference ties are as shown below.

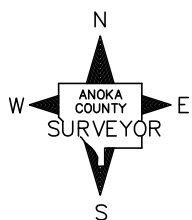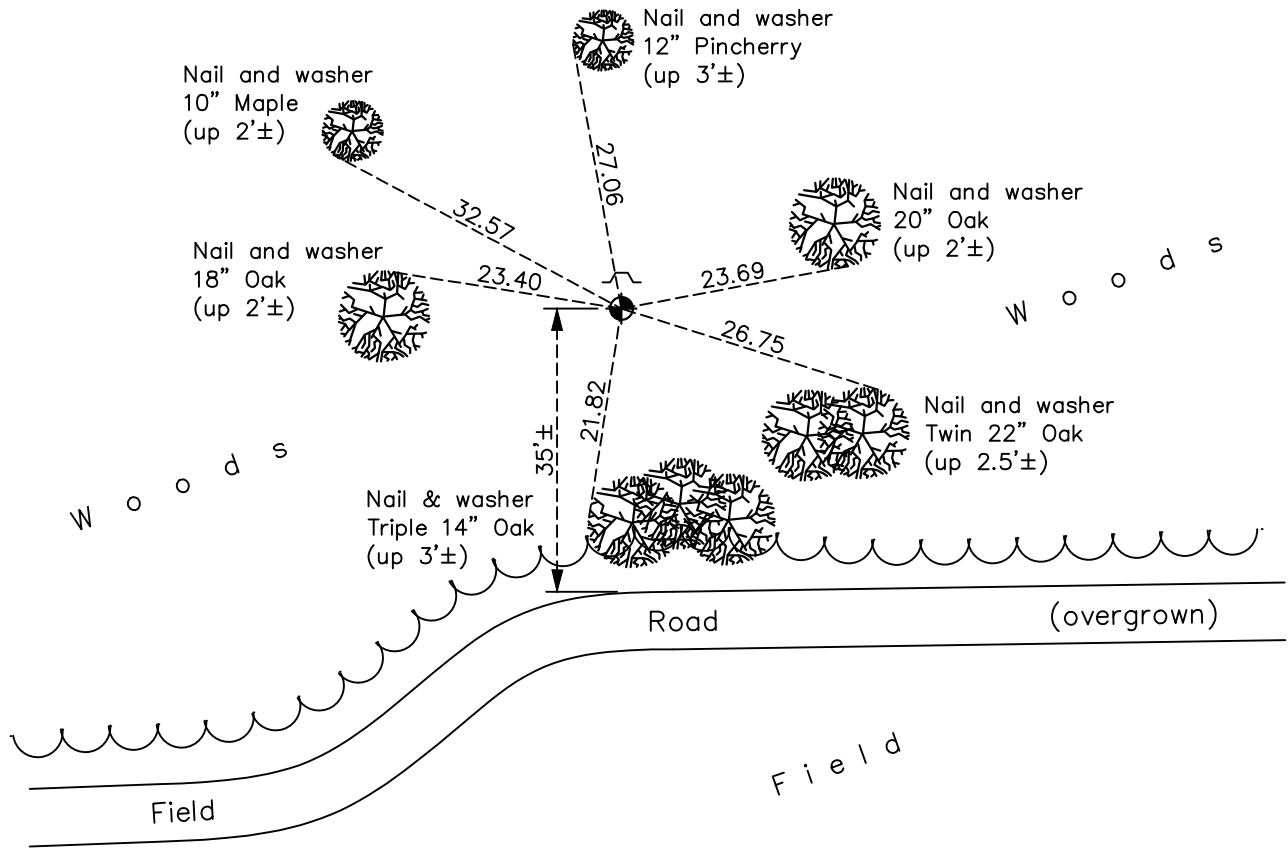

Revision Date
03/17/22

N.A.D. 1983 Coordinates
(1996 Adjustment)

| County Project Coordinates | |
|----------------------------|--------------------|
| Northing | <u>221986.0954</u> |
| Easting | <u>536948.0014</u> |
| Date | <u>4/19/04</u> |

I hereby certify that this United States public land survey monument record is correct and complete to the best of my knowledge and belief.

David Zieglmeier Date 12/11/23

David M. Zieglmeier, Anoka County Surveyor
Minnesota License Number 46179

HISTORY OF GOVERNMENT CORNER

Page No. 33

County of Anoka

State of Minnesota

Northwest Corner of Sec. 8 Township 33 Range 22

CORNER HISTORY:

December 10, 1946 - Found iron pipe and updated ties.

November 24, 1959 - Found 1 1/2" iron pipe and updated ties.

May 29, 1964 - Found iron pipe and updated ties.

July 7, 1967 - Found iron pipe and updated ties.

July 15, 1971 - Found iron pipe and updated ties.

July 23, 1975 - Found iron pipe and updated ties.

July 20, 1978 - Found iron pipe and updated ties.

August 19, 1981 - Found iron pipe and updated ties.

August 12, 1987 - Found iron pipe and updated ties.

March 27, 1991 - Found iron pipe and updated ties.

January 10, 1992 - Found 1 1/2" iron pipe and replaced with a cast iron monument. Updated ties

April 19, 2004 - Established NAD 1983 (1996 adj.) Anoka County project coordinates by static GPS methods.

December 5, 2013 - Found cast iron monument and updated ties.

May 1, 2019 - Found cast iron monument flush and updated the ties.

December 14, 2021 - Found cast iron monument flush. Verified position by VRS GPS methods. updated the ties.