

CERTIFICATE OF LOCATION OF GOVERNMENT CORNER

County of Anoka

State of Minnesota


CENTER Corner of Sec. 7 Township 33 Range 22

I hereby certify that on the 25 day of AUGUST, 1966, I found the described corner which was evidenced by 1 1/2" IRON PIPE

and I further certify that to perpetuate the location of said corner, I did, at the exact location thereof, place a permanent marker consisting of SAME

which reference or witness monuments are located in the manner following:

1-27-2021
JS UNABLE
TO FIND +
NO SWING
TIES

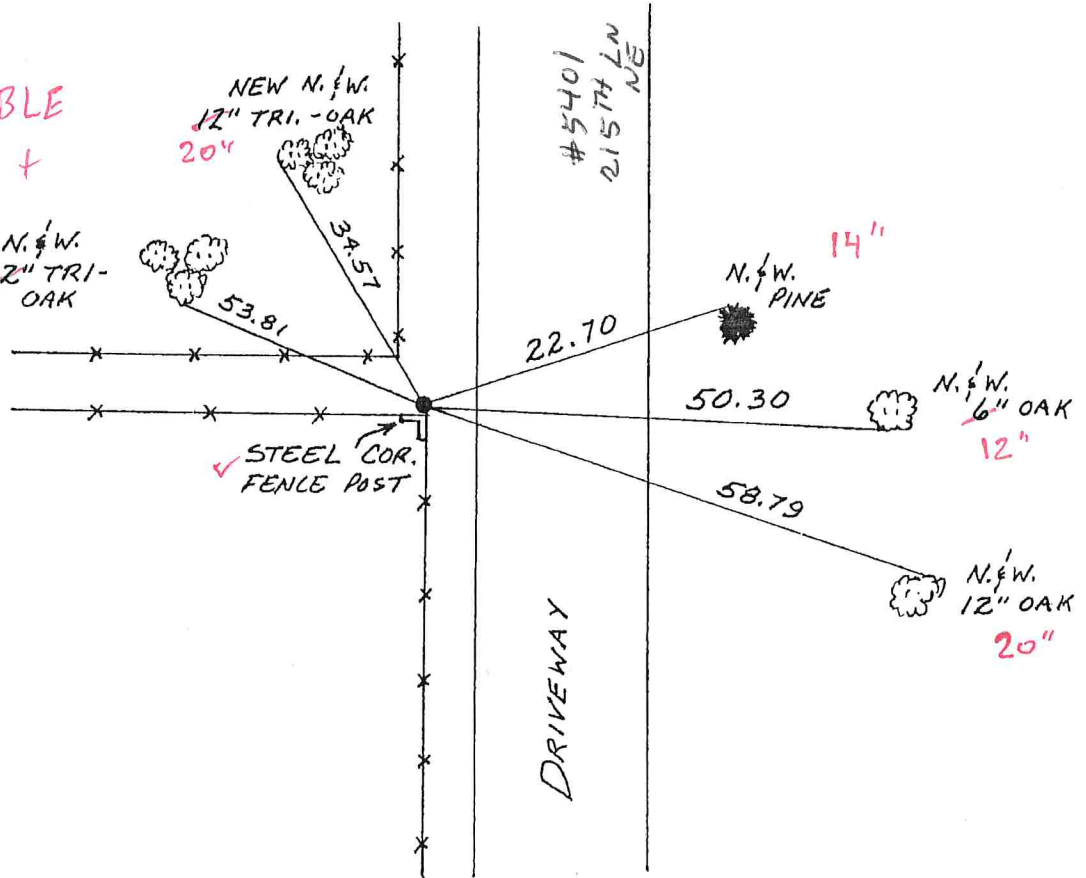

Revised date	Revised date	Revised date
10-18-90		

