

CERTIFICATE OF LOCATION OF GOVERNMENT CORNER

County of Anoka

State of Minnesota


West 1/4 Corner of Sec. 8 Township 33 Range 22

On the 24th day of November, 1959, the described corner was evidenced by a pinched iron pipe

and to perpetuate the location of said corner, at the exact location thereof, a permanent marker was placed consisting of a cast iron monument

AND on the 4th day of March, 2022, said permanent marker was found flush and the ties were updated

Updated reference ties are as shown below.

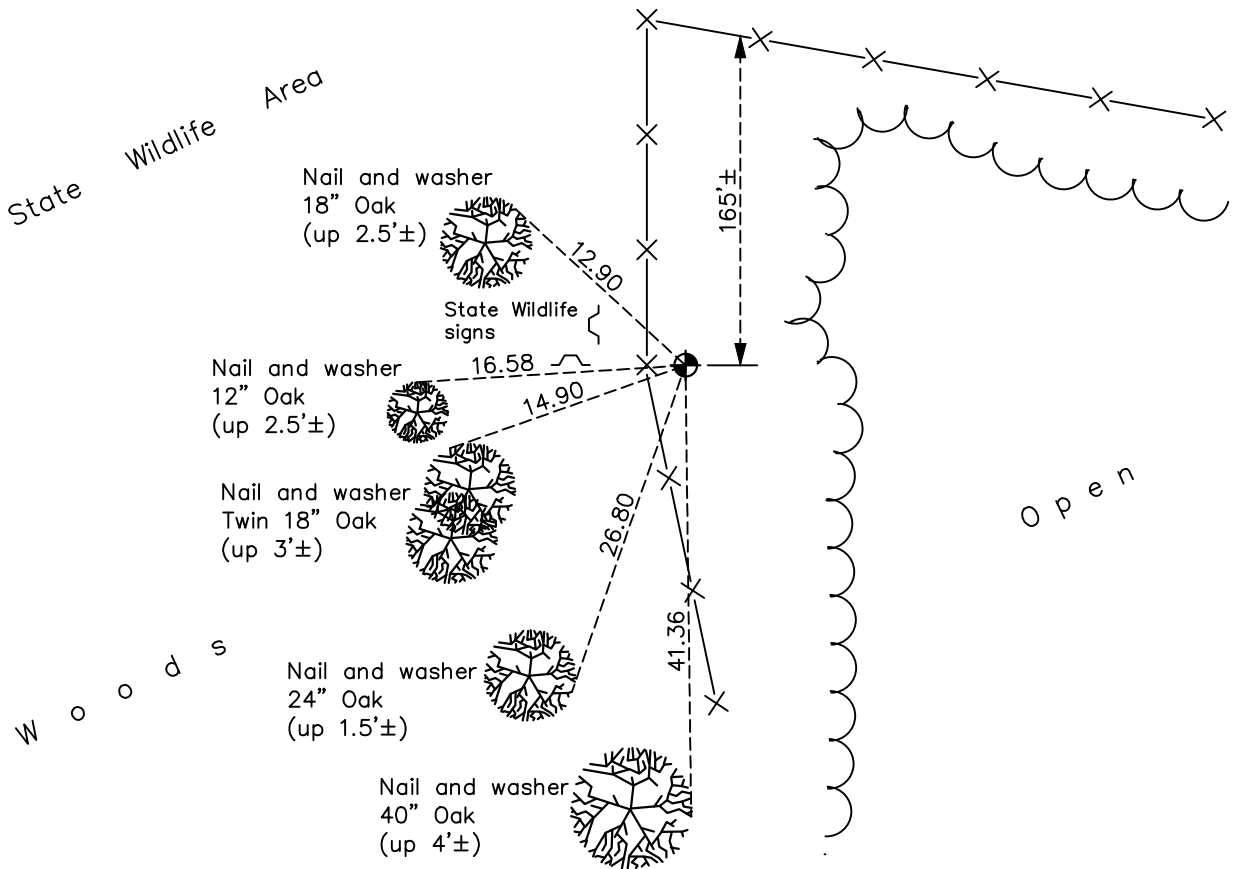

Revision Date
03/17/22

N.A.D. 1983 Coordinates
 (1996 Adjustment)

County Project Coordinates	
Northing	<u>219337.5873</u>
Easting	<u>536922.0955</u>
Date	<u>3/01/05</u>

I hereby certify that this United States public land survey monument record is correct and complete to the best of my knowledge and belief.

David Zieglmeier Date 12/11/23

David M. Zieglmeier, Anoka County Surveyor
 Minnesota License Number 46179

HISTORY OF GOVERNMENT CORNER

Page No. 38

County of Anoka

State of Minnesota

West 1/4 Corner of Sec. 8 Township 33 Range 22

CORNER HISTORY:

November 24, 1959 - Found pinched iron pipe and updated ties.

July 6, 1967 - Found pinched iron pipe and replaced with a cast iron monument flush. Updated ties.

July 6, 1971 - Found cast iron monument and updated ties.

July 23, 1975 - Found cast iron monument and updated ties.

July 20, 1978 - Found cast iron monument and updated ties.

August 24, 1981 - Found cast iron monument and updated ties.

August 24, 1984 - Found cast iron monument and updated ties.

August 12, 1987 - Found cast iron monument and updated ties.

August 9, 1995 - Found cast iron monument and updated ties.

March 1, 2005 - Established NAD 1983 (1996 adj.) Anoka County project coordinates by static GPS methods.

November 27, 2013 - Found cast iron monument and updated ties.

May 3, 2019 - Found cast iron monument flush. Verified position by VRS GPS methods. Updated ties.

March 4, 2022 - Found cast iron monument flush. Verified position by VRS GPS methods. Updated ties.