

CERTIFICATE OF LOCATION OF GOVERNMENT CORNER

County of Anoka

State of Minnesota


West 1/4 Corner of Sec. 9 Township 33 Range 22

On the 28th day of December, 1961, the described corner was evidenced by area resurvey

and to perpetuate the location of said corner, at the exact location thereof, a permanent marker was placed consisting of a cast iron monument with a sign and post on the north side

AND on the 28th day of June, 2023, said permanent marker was found flush and the position was verified as correct using County RTK GPS method

Updated reference ties are as shown below.

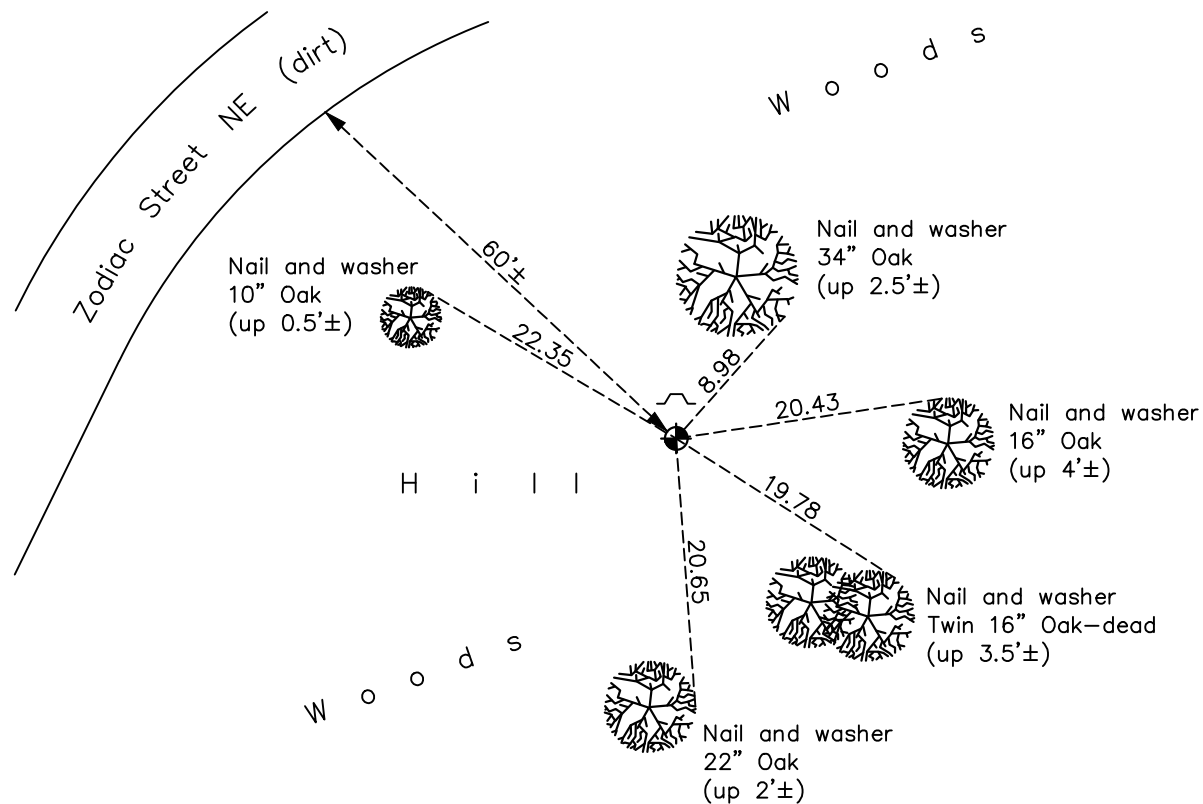

Revision Date
6/22/2023

N.A.D. 1983 Coordinates
(1996 Adjustment)

County Project Coordinates	
Northing	<u>219573.4179</u>
Easting	<u>542337.7215</u>
Date	<u>4/07/04</u>

I hereby certify that this United States public land survey monument record is correct and complete to the best of my knowledge and belief.

David Zieglermeier Date 12/11/23

David M. Zieglermeier, Anoka County Surveyor
Minnesota License Number 46179

HISTORY OF GOVERNMENT CORNER

Page No. 40

County of Anoka

State of Minnesota

West 1/4 Corner of Sec. 9 Township 33 Range 22

CORNER HISTORY:

December 28, 1961 - Set cast iron monument by doubling distance and running line from center through 1/16 corner from the east. Established ties to monument.

September 2, 1966 - Found cast iron monument and updated ties.

June 28, 1967 - Found cast iron monument and updated ties.

July 6, 1971 - Found cast iron monument and updated ties.

July 23, 1975 - Found cast iron monument and updated ties.

July 21, 1978 - Found cast iron monument and updated ties.

April 16, 1980 - Found cast iron monument and set construction ties prior to power line construction.

August 10, 1981 - Found cast iron monument and updated ties.

August 24, 1984 - Found cast iron monument and updated ties.

October 18, 1990 - Found cast iron monument and updated ties.

June 28, 1993 - Found cast iron monument and updated ties.

April 7, 2004 - Established NAD 1983 (1996 adj.) Anoka County project coordinates by static GPS methods.

November 26, 2013 - Found cast iron monument and updated ties.

January 25, 2019 - Found cast iron monument and updated ties.

December 7, 2021 - Found cast iron monument flush. Verified position by VRS GPS methods. Updated ties.

February 28, 2023 - Found cast iron monument flush. Verified position by ACS RTK GPS methods