

# CERTIFICATE OF LOCATION OF GOVERNMENT CORNER

County of Anoka

State of Minnesota


## Southeast Corner of Sec. 12 Township 33 Range 22

On the 25th day of August, 1975, the described corner was evidenced by a granite monument

and to perpetuate the location of said corner, at the exact location thereof, a permanent marker was placed consisting of the same granite monument up 2'±

AND on the 28th day of November, 2022, said permanent marker was found granite monument up 0.4'± with sign and post on North side, sign in poor condition. Ties were updated.

Updated reference ties are as shown below.

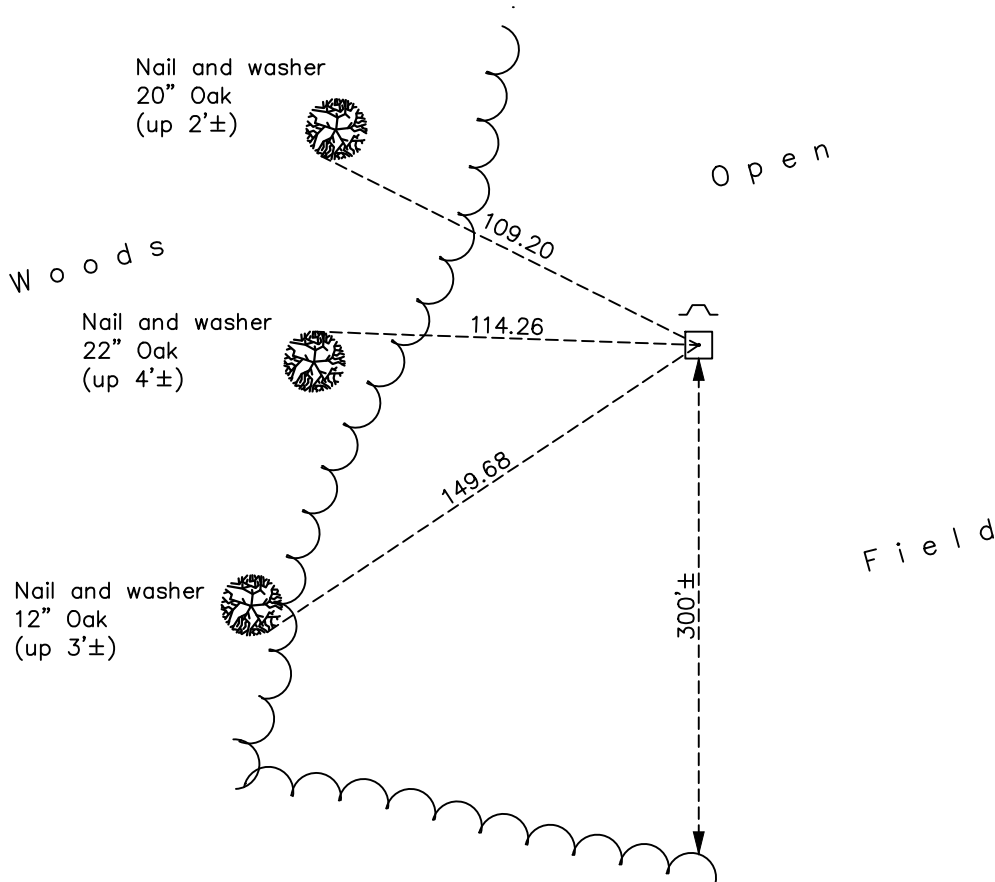

Revision Date  
 12/02/2022

N.A.D. 1983 Coordinates  
 (1996 Adjustment)

County Project Coordinates	
Northing	<u>216488.0632</u>
Easting	<u>563597.2538</u>
Date	<u>3/21/05</u>

I hereby certify that this United States public land survey monument record is correct and complete to the best of my knowledge and belief.  
*David Zieglmeier* Date 6/28/23  
 David Zieglmeier Anoka County Surveyor  
 Minnesota License Number 46179

# HISTORY OF GOVERNMENT CORNER

County of Anoka

State of Minnesota

## Southeast Corner of Sec. 12 Township 33 Range 22

### **CORNER HISTORY:**

December 15, 1909 - Found monument and established ties to monument.

August 25, 1975 - Found granite monument up 0.5'± and updated ties.

July 24, 1978 - Found granite monument and updated ties.

August 12, 1981 - Found granite monument and updated ties.

March 27, 1991 - Found granite monument and updated ties.

March 21, 2005 - Established NAD 1983 (1996 adj.) Anoka County project coordinates by static GPS methods.

November 28, 2022 - Found granite monument, verified position by GPS VRS method and updated ties.