

# CERTIFICATE OF LOCATION OF GOVERNMENT CORNER

County of Anoka

State of Minnesota


## South 1/4 Corner of Sec. 9 Township 33 Range 22

On the 30th day of November, 1955, the described corner was evidenced by a railroad rail found by E.A. Westman

and to perpetuate the location of said corner, at the exact location thereof, a permanent marker was placed consisting of a cast iron monument with a sign and post on the north side

AND on the 23rd day of December, 2021, said permanent marker was found flush and the ties were updated

Updated reference ties are as shown below.

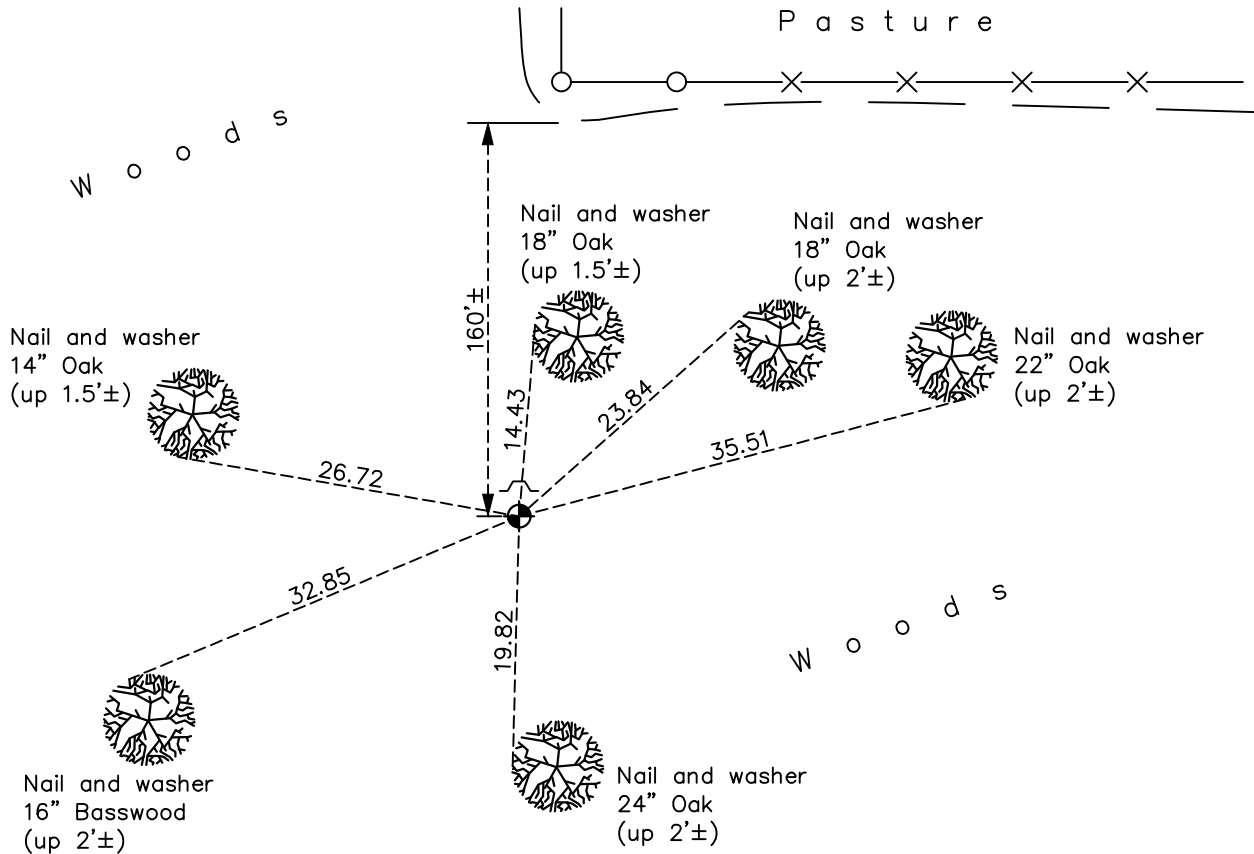

N.A.D. 1983 Coordinates  
(1996 Adjustment)

County Project Coordinates	
Northing	<u>216790.9468</u>
Easting	<u>544815.1633</u>
Date	<u>5/12/04</u>

I hereby certify that this United States public land survey monument record is correct and complete to the best of my knowledge and belief.

*David Zieglsmeier* Date 12/11/23

David M. Zieglsmeier, Anoka County Surveyor  
Minnesota License Number 46179

Revision Date

03/17/22

# HISTORY OF GOVERNMENT CORNER

Page No. 54

County of Anoka

State of Minnesota

South 1/4 Corner of Sec. 9 Township 33 Range 22

## **CORNER HISTORY:**

November 30, 1955 - Found iron railroad rail in ground on fence line. Established ties to railroad rail by E. A. Westman.

August 27, 1964 - Found railroad rail and updated ties.

July 11, 1967 - Found railroad rail and updated ties.

July 9, 1971 - Found railroad rail and replaced with a cast iron monument. Updated ties.

July 24, 1975 - Found cast iron monument and updated ties.

July 24, 1978 - Found cast iron monument and updated ties.

August 26, 1981 - Found cast iron monument and updated ties.

October 18, 1990 - Found cast iron monument and updated ties.

June 24, 1993 - Found cast iron monument and updated ties.

August 10, 2003 - Found cast iron monument and updated ties.

May 12, 2004 - Established NAD 1983 (1996 adj.) Anoka County project coordinates by static GPS methods.

November 27, 2013 - Found cast iron monument and updated ties.

May 2, 2019 - Found cast iron monument flush and updated ties.

December 23, 2021 - Found cast iron monument flush. Verified position by VRS GPS methods. Updated ties.