## CERTIFICATE OF LOCATION OF GOVERNMENT CORNER County of Anoka State of Minnesota


Southeast Corner of Sec. 22 Township 33 Range 22

On the 10th day of September, 1975, the described corner was evidenced by a concrete monument with a steel post

and to perpetuate the location of said corner, at the exact location thereof, a permanent marker was placed consisting of the same concrete monument with steel post

AND on the 25th day of May, 2004, said permanent marker was found and the ties were <u>updated. Half of the monument was above ground, it was loose and leaning to the northwest.</u>

Updated reference ties are as shown below.

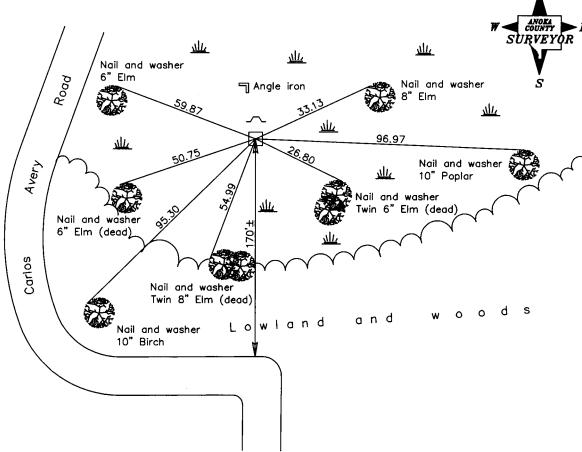

## Revised date

2/19/86
8/13/87
5/25/04

N.A.D. 1983 Coordinates (1996 Adjustment)

County F	Project Coordinates
Northing	206041.7561
Easting	552931.7478
Date	5/25/04

I hereby certify that this United States public land survey monument record is correct and complete the best of my knowledge and belief.

Bate <u>5/25/</u>04 arry D. Hoium

, Anoka County Surveyor

18165 Minnesota License Number