

# CERTIFICATE OF LOCATION OF GOVERNMENT CORNER

County of Anoka

State of Minnesota


## North 1/4 Corner of Sec. 29 Township 34 Range 22

On the 1st day of February, 1979, the described corner was evidenced by area resurvey

and to perpetuate the location of said corner, at the exact location thereof, a permanent marker was placed consisting of a cast iron monument with a sign and post on the north side

AND on the 31th day of March, 2022, said permanent marker was found down 0.1'± and and the ties were updated

Updated reference ties are as shown below.

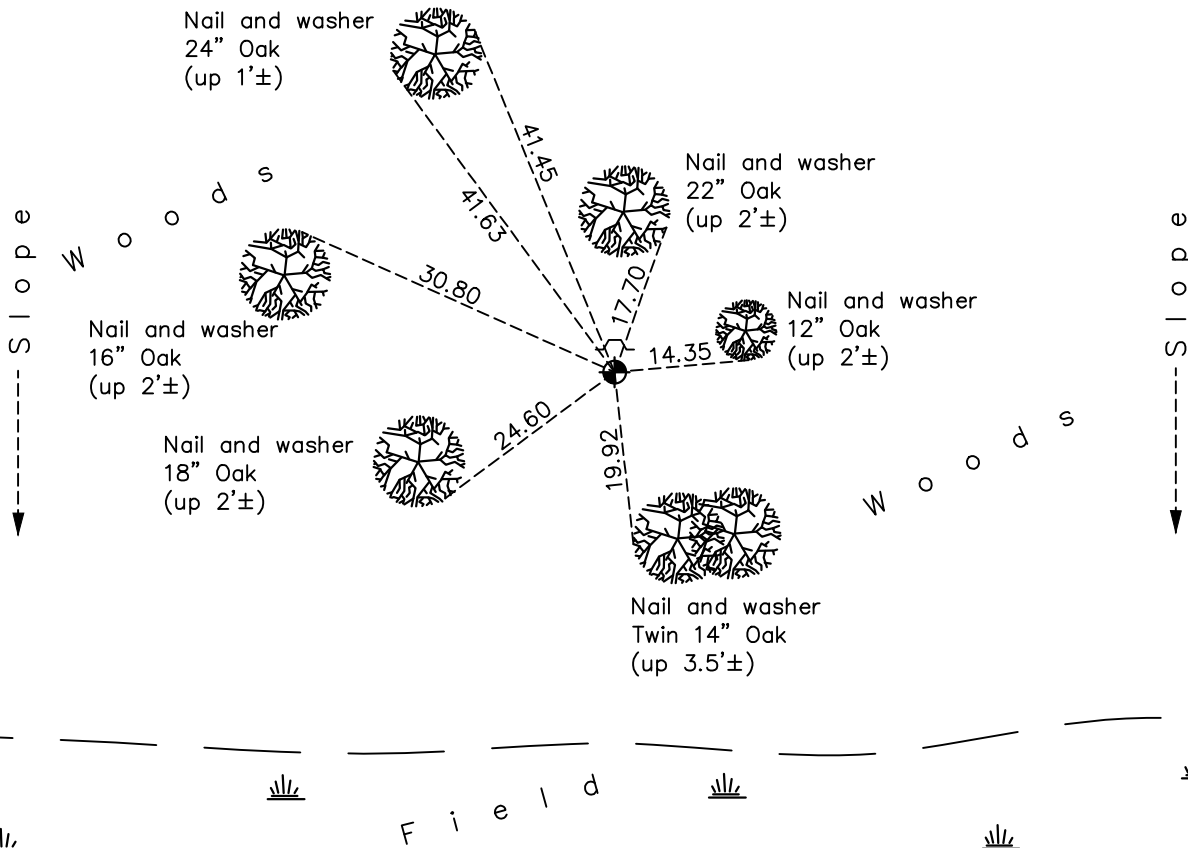

Revision Date  
4/07/2022

N.A.D. 1983 Coordinates  
 (1996 Adjustment)

County Project Coordinates	
Northing	<u>238039.3703</u>
Easting	<u>539554.2029</u>
Date	<u>3/31/04</u>

I hereby certify that this United States public land survey monument record is correct and complete to the best of my knowledge and belief.  
*David Zieglmeier* Date 3/22/24  
 David Zieglmeier Anoka County Surveyor  
 Minnesota License Number 46179

# HISTORY OF GOVERNMENT CORNER

Page No. 12

County of Anoka

State of Minnesota

North 1/4 Corner of Sec. 29 Township 34 Range 22

## **CORNER HISTORY:**

February 1, 1979 - Set cast iron monument flush using area resurvey and established ties to monument.

June 9, 1982 - Found cast iron monument and updated ties.

August 13, 1986 - Found cast iron monument and updated ties.

January 19, 1988 - Found cast iron monument up 0.1' and updated ties.

July 12, 1993 - Found cast iron monument and updated ties.

March 31, 2004 - Established NAD 1983 (1996 adj.) Anoka County project coordinates by static GPS methods.

May 5, 2014 - Found cast iron monument and updated ties.

June 5, 2019 - Found cast iron monument down 0.1'± and updated ties.

March 31, 2022 - Found cast iron monument down 0.1'± and verified position by VRS GPS method. Updated ties.