

CERTIFICATE OF LOCATION OF GOVERNMENT CORNER

County of Anoka

State of Minnesota



East 1/4 Corner of Sec. 26 Township 34 Range 22

On the 20th day of June, 1967, the described corner was evidenced by a concrete monument

and to perpetuate the location of said corner, at the exact location thereof, a permanent marker was placed consisting of the same concrete monument with a sign and post on the north side

AND on the 18th day of February, 2014, said permanent marker was found leaning southwesterly and the ties were updated

Updated reference ties are as shown below.

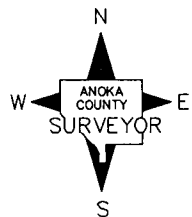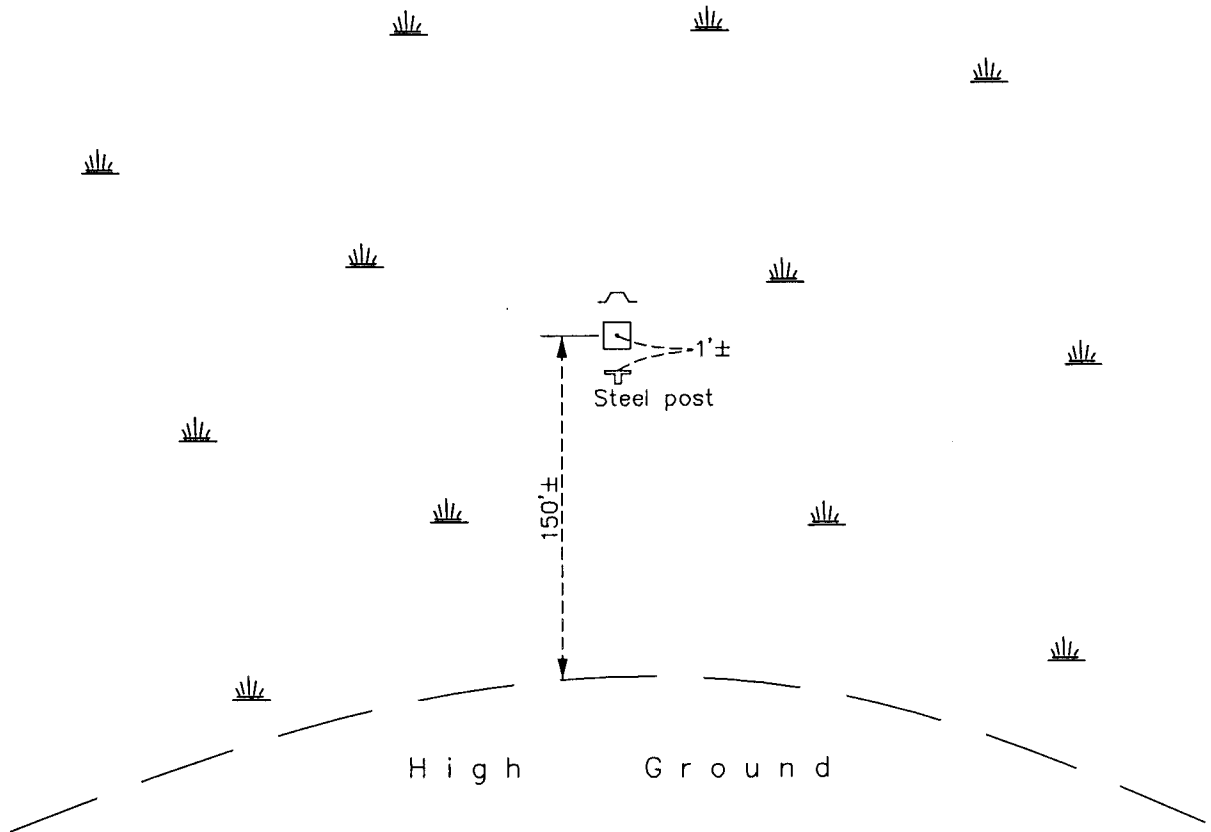

Revision Date

12/15/15

N.A.D. 1983 Coordinates
(1996 Adjustment)

| County Project Coordinates | |
|----------------------------|--------------------|
| Northing | <u>234835.3245</u> |
| Easting | <u>558249.4039</u> |
| Date | <u>2/10/04</u> |

I hereby certify that this United States public land survey monument record is correct and complete to the best of my knowledge and belief.

Larry D. Hoium Date 12/15/15

Larry D. Hoium, Anoka County Surveyor
Minnesota License Number 18165