

CERTIFICATE OF LOCATION OF GOVERNMENT CORNER

County of Anoka

State of Minnesota



West 1/4 Corner of Sec. 34 Township 34 Range 22

On the 2nd day of January, 1975, the described corner was evidenced by a 1" iron pipe

and to perpetuate the location of said corner, at the exact location thereof, a permanent marker was placed consisting of a red and white iron pipe

AND on the 12th day of February, 2014, said permanent marker was found up 3'± and the ties were updated

Updated reference ties are as shown below.

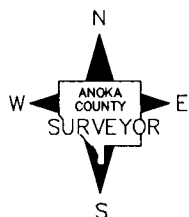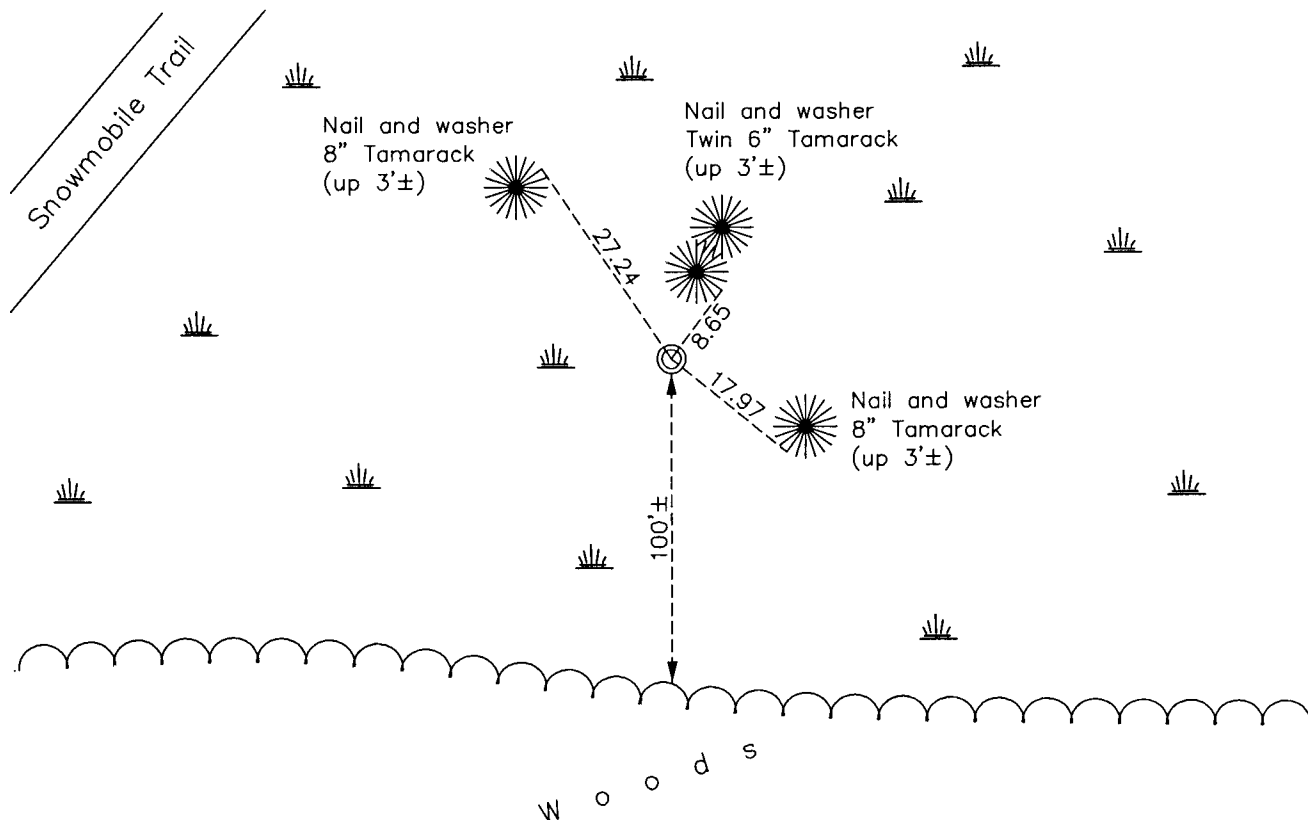

Revision Date

12/24/15

N.A.D. 1983 Coordinates
(1996 Adjustment)

County Project Coordinates

Northing 229872.2085Easting 547784.9670Date 2/12/04

I hereby certify that this United States public
land survey monument record is correct and
complete to the best of my knowledge and belief.

Larry D. Hoium Date 12/24/15

Larry D. Hoium, Anoka County Surveyor

Minnesota License Number 18165